

Jones  
 (3) M 3  
 7-67

MISSISSIPPI  
 BOARD OF WATER COMMISSIONERS  
 416 North State Street  
 Jackson, Mississippi 39201

WATER WELL DRILLERS LOG

7-20-67 date well completed 1967 Roy V. West firm name Jones county well located


LANDOWNER: Shane W. Landrum  
 Rt 1 Orville Miss  
 (mailing address)

description of formations encountered	from	to
clay	1	10
Red sand	10	20
Clay and gray	20	80
Blue clay	80	105
fine sand	105	109
green clay	109	147
gray sand	147	168

WELL LOCATION:  
 sec 18 T 7 N R 10 E  
 S W  
 14 miles S-E of Laurel Miss  
 (distance) (direction) (nearest town)

WELL PURPOSE: Chicken house  
 (home, irrigation, municipal, industrial)

- WELL COMPLETION DATA:
- (1) diameter (inches) 2
  - (2) total depth (feet) 760
  - (3) static water level (feet) 37 below top of ground. above
  - (4) casing galv 155  
 (material) (depth)  
 If telescope see back.  
 (size)
  - (5) screen 5 ft 155  
 (length) (depth to top)  
1/4 stainless steel  
 (size) (material)
  - (6) pump 3/4 12 gals per min  
 (HP) (yield gpm)  
P.E.A.  
 (type power)
  - (7) electric log no  
 (yes or no)  
 (organization running log)
  - (8) how well bottom plugged clay

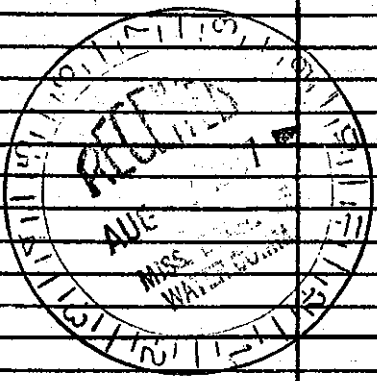

DRILLERS REMARKS: