

MISSISSIPPI BOARD OF WATER COMMISSIONERS

Jones
MG
10-24-60

9/


WATER WELL DRILLERS LOG

Case 7/1/69
JW
County Jones

Date: 10 24, 1960, Driller: H H Bolin (Name) County Jones

(1) Owner of Land	Description & Color of Materials Sand, Clay, Red Clay, Shell, etc.	Depth Feet
Lamar Valentin (Name)	White Clay	40
Elleenville R 2 (Address)	Gray	70
(2) Location: 1/4, 1/4, Sec. T. R.	Red	10
7 miles East of Elleenville (distance) (direction) (Nearest Town)	Blue	63
(3) Topography: (Hilly) (Flat) (Level)	White	31
(4) Purpose of Well: Home (Domestic Irrigation, Municipal, Industrial, Other)	Sand	20
Information upon completion of well:		
(1) Diameter 2" inches.		
(2) Total Depth 224 feet.		
(3) Water Level 40 feet below top of ground.		
(4) Cased to 212, Size 2"		
(5) Screen: Size 1 1/4, Length 12 ft.		
(6) Were any formations sealed against pollution?		
yes, no.		
If YES depth of formation		
Why		
Drillers Remarks:		

COPIED

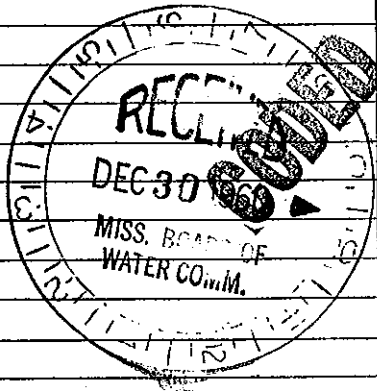

(Use Back Side)

Well No.

Mail this copy to Board of Water Commissioners 429 Miss. St. Jackson, Miss.