

1162

Walker 8-6

STATE WELL REPORT

Part 1

Driller's Log

Mississippi Department of Environmental Quality
Office of Land and Water Resources
P.O. Box 2309
Jackson, MS 39225-2309
(601)961-5210
(601)360-0535 (fax)

For Office Use Only:

Well #: M14
Aquifer: _____
E-Log #: _____

County: Jones
 Permit #: _____
 Driller: John W Thompson
 Date drilling completed: 4-28-16

State Law requires that this report be prepared by the license holder responsible for the work and filed with the Department at the above address within 30 days of completion of drilling of the well or borehole.

Well Owner Information <small>(Landowner if borehole is not for a water well)</small>			Well or Borehole Location	
Owner Name: <u>Venture Oil</u>			Latitude: <u>31°35'24.4"</u> Longitude: <u>89°01'23.8"</u>	
Mailing Address: <u>2075 13th Ave</u> <u>Laurel MS 39440</u>			Method of Lat/Long (check one): Conventional Survey _____	
City _____ State _____ Zip Code _____			USGS quad _____, Hand-held GPS _____, Survey-grade GPS _____	
Telephone No. (____) _____			<u>SE 1/4 NW 1/4, Sec 8 T 7N R 10W</u>	
			<u>4.5</u> Miles <u>SE</u> of <u>Tucker's Crossing</u>	
			<small>(Distance) (Direction) (Nearest Town)</small>	

Well / Borehole Data

Date drilling started: 4-27-16 Date drilling completed: 4-28-16 Hole depth: 200 Hole diameter: 7"
 Location of the source of any surface water used for drilling: Local Creek
 Method of dosing and volume of Chlorine used in drilling and development: added 6 gallons bleach
 Logs run (circle all applicable): No log run Electric Gamma Ray Density Sonic Neutron Other: _____
 Name of organization running log(s): _____
 Purpose of borehole (circle one): Water Well Geotechnical/Geological Investigation Ground Source Heat Pump
 Seismic Survey Other (describe) _____

If drilling is not related to water well construction, skip the remainder of this block


Purpose of Well (circle all applicable): Home Industrial Public Supply Irrigation Fish Culture
 Other (describe): rig supply
 If a flowing well, method of flow regulation: Valve _____ Other (describe) _____
 Static Water Level: 68 feet [above or (below) land surface Date measured: 4-28-16
(circle one)
 Method of measurement (circle one): Steel tape Electric tape Air line Other (describe): _____
 Well depth: 180 Well grouted to a depth of: 20 feet Type of grout (circle one): Neat Cement Bentonite Mix
 Casing length: 140 feet Casing diameter: 4 inches Type of casing: PVC
 Screen length: 40 feet Screen diameter: 4 inches Type of screen: PVC slotted
 Screen slot size: .010 inches Setting depth: From 140 feet to 180 feet
 Type of completion (circle all applicable): Gravel packed Underreamed Open hole Natural Development
 Other (describe): _____
 Top of lap pipe or reduction in casing: _____ feet

If telescoped or more than one screen, describe on next page

County: Jones
 Permit #: _____

For Office Use Only:
 Well #: M14

The sketch below only required for water wells
If well telescopes, show depths on sketch.

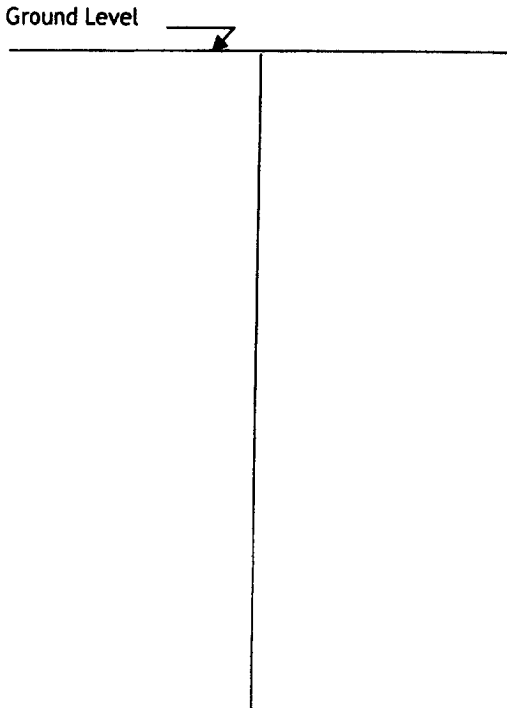

Description of formations encountered must be provided for all wells and boreholes, unless specifically exempted by regulations

Description of Formations Encountered	From (depth)	To (depth)
Clay	Ground level	30
blue clay	30	100
clay + fine sand	100	140
sand	140	175
clay + lignite	175	200

If more than one screen, show location of each on sketch

- Sketch the property layout and include the following:
- 1) the well location
 - 2) any permanent structures on the property that may aid in locating the well
 - 3) any roads, power lines, or other items that may aid in locating the property and the well
 - 4) north arrow

Landowner Name: Venture Oil + Gas

I HEREBY CERTIFY that the well/borehole was drilled, constructed, and completed in accordance with all applicable requirements of the Mississippi Department of Environmental Quality and the Mississippi Department of Health regulations, if applicable, and state laws.

John W Thompson 0-679 5-2-16 John W Thompson
 Print Name of Responsible Licensee and License No. Date Signature of Licensee

STATE WELL REPORT

Part 2

Pump Installer's Completion Report
 Mississippi Department of Environmental Quality
 Office of Land and Water Resources
 P.O. Box 2309
 Jackson, MS 39225-2309
 (601)961-5210
 (601) 360-0535 (fax)

County: Jones
 Permit #: _____
 Driller: John W Thompson
 Date completed: 4-28-16
Copy information from block on Part 1

For Office Use Only:

Well #: M14
 Aquifer: _____

This part of the report must be completed by a licensed water well contractor or a licensed pump installer. A copy of Part 1 of the report must be attached and both parts filed with the Department at the above address within 30 days of well completion.

Well Owner Information	Well Location
Owner Name: <u>Venture Oil & Gas</u>	Latitude: <u>31° 35' 24.4"</u> Longitude: <u>89° 01' 23.8"</u>
Mailing Address: <u>2075 13th Ave</u> <u>Laurel MS 39440</u>	Method of Lat/Long (check one): Conventional Survey _____ USGS quad _____, Hand-held GPS _____, Survey-grade GPS _____
City _____ State _____ Zip Code _____	_____ 1/4 _____ 1/4, Sec <u>8</u> T. <u>7N</u> R. <u>10W</u>
Telephone No. (____) _____	<u>4.5</u> Miles <u>SE</u> of <u>Tuckers Crossing</u> (Distance) (Direction) (Nearest Town)

Pump Type (circle one)

Submersible Turbine Air Lift Centrifugal Flowing Well Jet Piston Rotary Other (describe): _____

Date Pump Installed: 4-28-16 Rated Pump Capacity: 55 Gallons Per Minute

Is This Pump (circle one): New Repaired Replacement

Power Type (circle one)

Electric Diesel Gasoline Natural Gas Tractor PTO Windmill Other (describe): _____

Horse Power Rating of Motor: 5 Setting Depth: 160 feet Number of Stages: _____

Pump Test Data for Non Flowing Well

Date Well Tested: 4-28-16 Duration of Pump Test (minimum 4 hours): 4 hours

Static Water Level (A): 68 Feet Below Land Surface Pumping Water Level (B): 94 Feet Below Land Surface

Drawdown [(B) - (A)]: 26 Feet Below Land Surface Test Pumping Rate: 50 Gallons Per Minute

Method of measurement (circle one): Steel tape Electric tape Air line Other (describe): _____

Pump Test Data for Flowing Well

Measured shut in head: _____ feet.

Well yielded _____ GPM with a drawdown of _____ feet after _____ hours of pumping

Meter Installation

Meter Manufacturer: _____ Meter Serial Number: _____

Meter Model Number/Name: _____ Type of Meter: _____

Totalizer Register Unit and Multiplier Factor (AF x .001, gal x 1000, etc): _____

Installation Date: _____ Meter installed by: _____

Is This Meter (circle one): New Repaired Replacement

Important: By submitting the above information you are certifying that this meter was installed to manufacturer standards. For agricultural wells, a list of approved meters is on the MDEQ website.

I HEREBY CERTIFY that the above statements are true to the best of my knowledge.

John W Thompson 0-679 5-2-16 John W Thompson
 Print Name of Pump Installer and License No. (if applicable) Date Signature of Pump Installer