

MISSISSIPPI BOARD OF WATER COMMISSIONERS

JONES

WATER WELL DRILLERS LOG

In 1963

3) N 2
8-31-63

Date: 8/31, 1963, Driller: C.P. Clark County Jones

(Name)

(1) Owner of Land: Mosselle School
(Name)
Mosselle Miss
(Address)

(2) Location: NE 1/4, SE 1/4, Sec. 10 T 6 R 12 E
_____ miles in of Mosselle
(distance) (direction) (Nearest Town)

(3) Topography: _____
(Hilly) (Flat) (Level)

(4) Purpose of Well: School
(Domestic Irrigation
Municipal, Industrial, Other)

Description & Color of Materials
Sand, Clay, Red Clay, Shell, etc.

Thick-
ness
Feet

Depth
Feet

<u>12 hard white Clay</u>	<u>12</u>	
<u>12 - 32 Sand & Gravel</u>	<u>20</u>	

Information upon completion of well:

(1) Diameter 4 inches.

(2) Total Depth 32 feet.

(3) Water Level 8 feet below top of ground.

(4) Cased to 23, Size 4 in.


(5) Screen: Size 4, Length 10 ft.

(6) Were any formations sealed against pollution?
_____ yes, no.

If YES depth of formation _____

Why _____

Drillers Remarks: _____

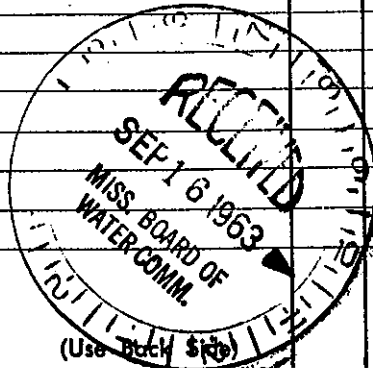

Well No.

Mail this copy to Board of Water Commissioners 429 Miss. St. Jackson, Miss!