

JONES
N 3
4-68

MISSISSIPPI
BOARD OF WATER COMMISSIONERS
416 North State Street
Jackson, Mississippi 39201

WATER WELL DRILLERS LOG

4/8 1969 STR Jones
date well completed firm name county well located


LANDOWNER: Fudge Bro
Rt 1
Marell, Miss
(mailing address)

description of fomations encountered	from	to
<u>Red Sandy Clay</u>	<u>0</u>	<u>14</u>
<u>Red Clay</u>	<u>14</u>	<u>55</u>
<u>Sy Clay Shale</u>	<u>55</u>	<u>70</u>
<u>Fire Sand</u>	<u>70</u>	<u>78</u>
<u>P W B Sand</u>	<u>78</u>	<u>90</u>

WELL LOCATION:
sec. 16 T. 6 N. R. 12 E.
S W
1 miles S-W of MARELL
(distance) (direction) (nearest town)

WELL PURPOSE: Home
(home, irrigation, municipal, industrial)

- WELL COMPLETION DATA:
- (1) diameter (inches) 2"
 - (2) total depth (feet) 90 ft
 - (3) static water level (feet) 68 below above top of ground.
 - (4) casing plastic, 90,
(material) (depth)
2" if telescope see back.
(size)
 - (5) screen 5 ft, 85 ft
(length) (depth to top)
2", plastic
(size) (material)
 - (6) pump 1 (HP) 600 hp
(type power)
 - (7) electric log no (yes or no)
None (organization running log)
 - (8) how well bottom plugged None

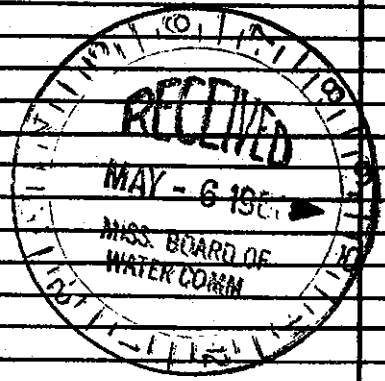

DRILLERS REMARKS: