

JONES

MISSISSIPPI BOARD OF WATER COMMISSIONERS

WATER WELL DRILLERS LOG

N 300

12-28-60

Date: 12/28, 1960, Driller: Tims

County Jones

(Name)

(1) Owner of Land: M.A. Eaton  
(Name)

Rt 1 Moreh.  
(Address)

(2) Location: One lot  
1/4, Sec. 12, T. 6, R. 13

2 miles east of Moreh.  
(distance) (direction) (Nearest Town)

(3) Topography: Hilly  
(Hilly) (Flat) (Level)

(4) Purpose of Well: Home  
(Domestic Irrigation Municipal, Industrial, Other)

Description & Color of Materials  
Sand, Clay, Red Clay, Shell, etc.

Thick-  
ness  
Feet

Depth  
Feet

0-80 Red Clay  
80-100 Sand White  
100-110 Gravel

Information upon completion of well:

(1) Diameter 2 inches.

(2) Total Depth 110 feet.

(3) Water Level 35 feet below top of ground.

(4) Cased to 105 ft, Size 2"

(5) Screen: Size 2", Length 5 ft


(6) Were any formations sealed against pollution?

no yes, no

If YES depth of formation \_\_\_\_\_

Why \_\_\_\_\_

Drillers Remarks: \_\_\_\_\_

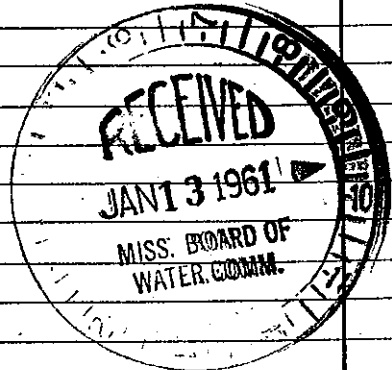

(Use Back Side)

Mail this copy to Board of Water Commissioners 429 Miss. St. Jackson, Miss