

JONES

MISSISSIPPI BOARD OF WATER COMMISSIONERS

⑥ N 13

5-6-61

WATER WELL DRILLERS LOG

2

Date: 5-6, 1961; Driller: Jay Rott County Forrest

	Description & Color of Materials Sand, Clay, Red Clay, Shell, etc.	Thick- ness Feet	Depth Feet
(1) Owner of Land: <u>D. K. R. O'Neal</u> (Name) <u>Rt 1, Hattiesburg, Miss</u> (Address)	white sand		20
(2) Location: $\frac{1}{4}$, $\frac{1}{4}$, Sec. <u>15</u> T <u>6</u> R <u>15</u>	Red clay		30-30
<u>10</u> miles <u>N</u> , of <u>Hattiesburg</u> (distance) (direction) (Nearest Town)	white clay		30-200
(3) Topography: <u>Hilly</u> (Hilly) (Flat) (Level)	Rock		200-210
(4) Purpose of Well: <u>Domestic</u> (Domestic Irrigation Municipal, Industrial, Other)	white clay		210-240
	Blue clay		240-260
	white clay		260-292
	" Sand		292-295
	Blue clay		295-330
	white sand		330-360


Information upon completion of well:

- (1) Diameter 2 inches.
- (2) Total Depth 360 feet.
- (3) Water Level 95 feet below top of ground.
- (4) Cased to bottom, Size 2 in.
- (5) Screen: Size 2 in, Length 10 ft.
- (6) Were any formations sealed against pollution?
 yes, no.

If YES depth of formation _____

Why _____

Drillers Remarks: _____

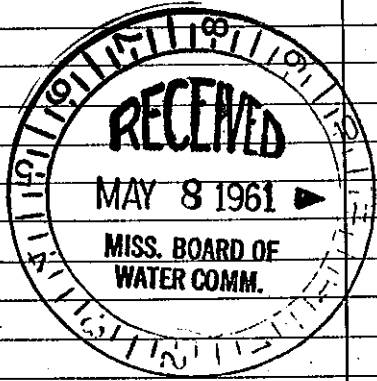

(Use Back Side)

Well No.

Mail this copy to Board of Water Commissioners 429 Miss. St. Jackson, Miss.