

JONES


MISSISSIPPI BOARD OF WATER COMMISSIONERS

① N 15  
4-28-64

WATER WELL DRILLERS LOG

Date: 4/28 1964, Driller: Jay Lett

Hattiesburg Butane Gas Co. (Name)

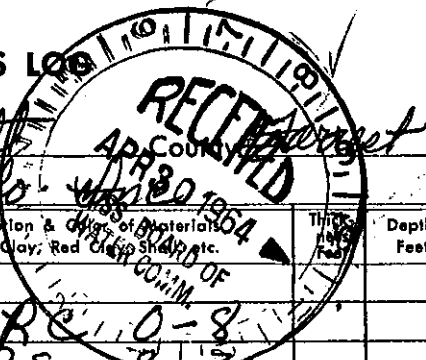

(1) Owner of Land: Gus D. Saucier (Name)  
Rt 7 Hattiesburg, Miss (Address)

Description & Colors of Materials  
Sand, Clay, Red Clay, Shale, etc.

Depth Feet

(2) Location: 1/4, 1/4, Sec. 22 T6N R13W  
8 miles N of Hattiesburg (direction) (Nearest Town)

RS 8-30  
WC 30-110  
BC 110-180  
NS 180-210

(3) Topography: (Hilly) (Flat) (Level)

(4) Purpose of Well: Domestic (Domestic Irrigation, Municipal, Industrial, Other)

Information upon completion of well:

(1) Diameter 2 inches.

(2) Total Depth 210 feet.

(3) Water Level 72 feet below top of ground.

(4) Cased to \_\_\_\_\_, Size \_\_\_\_\_.

(5) Screen: Size 2, Length 16 ft.

(6) Were any formations sealed against pollution?  
\_\_\_\_\_ yes, \_\_\_\_\_ no.

If YES depth of formation \_\_\_\_\_.

Why \_\_\_\_\_.

Drillers Remarks: \_\_\_\_\_

Well No.

(Use Back Side)

Mail this copy to Board of Water Commissioners 429 Miss. St. Jackson, Miss.