

JONES MISSISSIPPI BOARD OF WATER COMMISSIONERS

⑤ N 16
7-24-65

WATER WELL DRILLERS LOG


Date: July 24, 1965, Driller: H. J. Money County Jones
(Name)

	Description & Color of Materials Sand, Clay, Red Clay, Shell, etc.	Thick- ness Feet	Depth Feet
(1) Owner of Land: <u>B. H. Wright</u> (Name) <u>Rt #1 Ellersville, Miss</u> (Address)			
(2) Location: <u>23 T 7 N 10 W</u> <u>10 miles South</u> of <u>Ellersville</u> (distance) (direction) (Nearest Town)	<u>Clay Chalk</u>		
(3) Topography: _____ (Hilly) (Flat) (Level)	<u>to 100' Sand</u>		
(4) Purpose of Well: <u>Home</u> (Domestic Irrigation Municipal, Industrial, Other)	<u>to 120' hard</u>		

Information upon completion of well:

- (1) Diameter 2 inches.
- (2) Total Depth 179 feet.
- (3) Water Level 100' feet below top of ground.
- (4) Cased to _____, Size _____.
- (5) Screen: Size 1 1/4, Length 6'.
- (6) Were any formations sealed against pollution?
_____ yes, _____ no.

If YES depth of formation _____
Why _____
Drillers Remarks: _____

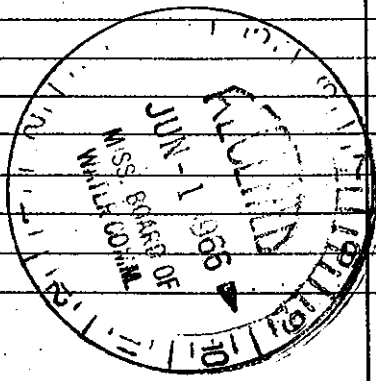

(Use Back Side)

Well No.

Retain this copy for your office files.