

MISSISSIPPI BOARD OF WATER COMMISSIONERS

WATER WELL DRILLERS LOG



JONES
N 19
2-68

Date: Feb 1, 1968, Driller: Leamon Throckmorton Jones
(Name)

(1) Owner of Land:	Description & Color of Materials Sand, Clay, Red Clay, Shell, etc.	Thick- ness Feet	Depth Feet
<u>C.N. Lounsbury</u> (Name)	<u>Chalk</u>	<u>0</u>	<u>320</u>
<u>Hattisburg, Miss</u> (Address)	<u>Sand</u>	<u>320</u>	<u>393</u>
(2) Location: <u>1/4</u> , <u>1/4</u> , Sec <u>34 T6R14</u>			
<u>9</u> miles <u>N.W.</u> of <u>Hattisburg</u> (distance) (direction) (Nearest Town)			
(3) Topography: <u>Hilly</u> (Hilly) (Flat) (Level)			
(4) Purpose of Well: <u>Commercial</u> (Domestic Irrigation Municipal, Industrial, Other)			

Information upon completion of well:

- (1) Diameter 4" inches.
- (2) Total Depth 393' feet.
- (3) Water Level 118' feet below top of ground.
- (4) Cased to 4", Size 2 10
- (5) Screen: Size 2", Length 15"
- (6) Were any formations sealed against pollution?
no

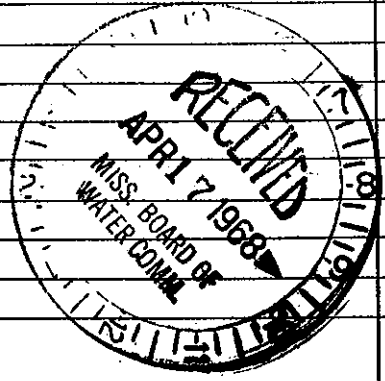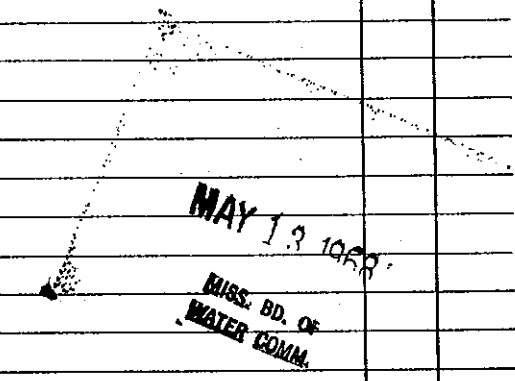

(Use Back Side)

Well No.

Mail this copy to Board of Water Commissioners 429 Miss. St. Jackson, Miss.