

JONES
N 20
3-68

MISSISSIPPI
BOARD OF WATER COMMISSIONERS
416 North State Street
Jackson, Mississippi 39201

WATER WELL DRILLERS LOG


march 4 1968 Heaman Thrash Jones
date well completed firm name county well located

LANDOWNER: <u>John D. Thrash</u>	description of formations encountered	from	to
<u>Rt 1</u>	<u>Sand & Gravel</u>	<u>0</u>	<u>50'</u>
<u>Moselle, Miss</u>	<u>Chalk</u>	<u>50</u>	<u>370</u>
(mailing address)	<u>Sand</u>	<u>370</u>	<u>423</u>

WELL LOCATION:
sec. 35 T 6 N R. 14 E
9 1/2 miles NW of Battaly
(distance) (direction) (nearest town)

WELL PURPOSE: Home
(home, irrigation, municipal, industrial)

- WELL COMPLETION DATA:
- (1) diameter (inches) 2"
 - (2) total depth (feet) 423'
 - (3) static water level (feet) 123' below top of ground.
 - (4) casing 2" galv. (material) 417' (depth)
(size) if telescope see back.
 - (5) screen 5' (length) (depth to top)
2" (size) ST. Steel (material)
 - (6) pump 2 H.P. (HP) 13 (yield gpm)
220 (type power)
 - (7) electric log NO (yes or no)
(organization running log)
 - (8) how well bottom plugged

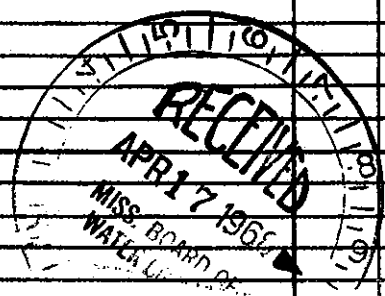

MAY 13 1968

MISS. BD. OF WATER COMM.

DRILLERS REMARKS: