

Jones
 N 24
 8-21-68

MISSISSIPPI
 BOARD OF WATER COMMISSIONERS
 416 North State Street
 Jackson, Mississippi 39201

CODED

WATER WELL DRILLERS LOG

8/21 1968 STR Jones
 date well completed firm name county well located


LANDOWNER: Clyde Hall
 RFD
 Moore, Miss
 (mailing address)

description of formations encountered	from	to
Sandy Clay	0	10
Red Sand	10	40
Sand + Gravel	40	90
Fine Sand	90	110
PWB Sand	110	142

WELL LOCATION:
 sec. 25 T 6 N R 13 E
 S W
 7 miles N of H Bog
 (distance) (direction) (nearest town)

WELL PURPOSE: Home
 (home, irrigation, municipal, industrial)

- WELL COMPLETION DATA:
- (1) diameter (inches) 2"
 - (2) total depth (feet) 142
 - (3) static water level (feet) 80 below above top of ground
 - (4) casing plastic, 137, (material) (depth)
 2" (size) If telescope see back.
 - (5) screen 5 ft, 137 (length) (depth to top)
 2" plastic (size) (material)
 - (6) pump 1 (HP) 700 G.P.M. (y/feld gpm)
 Jet (type power)
 - (7) electric log (yes or no)
 (organization running log)
 - (8) how well bottom plugged Valve

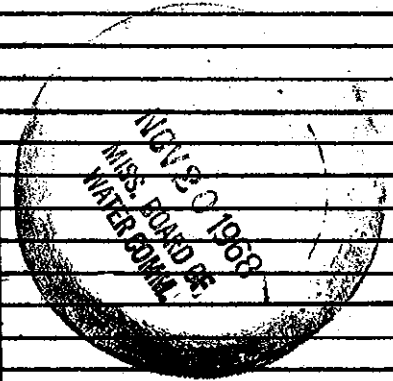

DRILLERS REMARKS: