

Jones

MISSISSIPPI DEPARTMENT OF ENVIRONMENTAL QUALITY

Office of Land and Water Resources

P. O. Box 10631
 Jackson, MS 39289-0631
 WATER WELL DRILLERS LOG

COUNTY WELL LOCATED Columbia	
WELL NUMBER N104	CODED
DATE WELL COMPLETED April 8 2020	

PERMIT NUMBER
NAME OF DRILLING FIRM K + Dally

NAME & MAILING ADDRESS OF LANDOWNER Gary Williamson Guthrie Center Rd.			
WELL LOCATION	SEC	TOWNSHIP	RANGE
	2	T-6 S	R-14 E
DISTANCE	DIRECTION	NEAREST TOWN	
8 Miles	SE	Seminary	
OTHER LANDMARK			
WELL PURPOSE (Home, Irrigation, Municipal, Industrial, Fish Pond, etc.) Home			

PUMP DATA		
PUMP TYPE (Circle One): Submersible, Turbine, Jet, Flowing Well, Other (Describe)		
POWER TYPE (Circle One): Electric, Tractor, Diesel, Gasoline, Butane, Other (Describe) H/P		
Pump Capacity (GPM) 6	No. of Stages	Setting Depth FT.
PUMP TEST		
Well yielded 6 GPM with a drawdown of _____ ft. after _____ hours of pumping		

WELL DATA		
Well Depth 140	Casing Diameter (In.) 2	Casing Length (Ft.) 130
Type of Casing Pvc	Hole Depth 140	Depth to Static Water Level 85
TYPE OF COMPLETION (Circle One or More): Gravel Packed, Underreamed, Telescoped, Natural Development, Open Hole, Other (Describe)		

LOG DATA	
TYPE OF LOG RUN (Circle One): No Log Run, Electric, Gamma Ray, Density, Sonic, Neutron, Other (Describe)	
Name of Organization Running Log	

WELL GROUTED TO A DEPTH OF 10 FEET
 Type Grout (circle one): Cement, Bentonite, or Mix

GEOLOGIC DATA (Office Use Only)			
Surface Elev.	Geologic Unit	Unit Thickness	Depth to Top
Subs SWL	Date	Analysis	Aquifer Test

SCREEN DATA		
Diameter - inches 2	Length - Feet 10	Slot Size - inches 12
Screen Type Pvc		Depth to Bottom - Feet 140


Driller's Remarks	
Top of Lap Pipe or Reduction in Casing	
FEET	IF TELESOPED OR MORE THAN ONE SCREEN: USE BACK PAGE

DESCRIPTION OF FORMATIONS ENCOUNTERED	FROM	TO	FORMATIONS (Continued)	FROM	TO
Topsoil	0	10			
clay red	10	35			
red sand/clay	35	90			
sand	90	140			

IF MORE SPACE IS NEEDED, USE BACK

If well telescopes please
sketch and show depths.

GROUND LEVEL

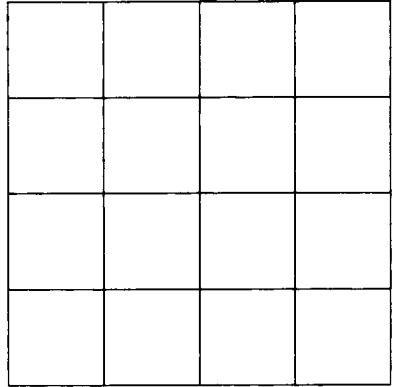

SECTION _____

Please indicate well location X.

ADDITIONAL INFORMATION

If more than one screen,
show location of each on sketch.