

STATE WELL REPORT

Part 1

Driller's Log

Mississippi Department of Environmental Quality
Office of Land and Water Resources
P.O. Box 2309
Jackson, MS 39225-2309
(601)961-5210
(601)360-0535 (fax)

For Office Use Only:

Well #: N 120
Aquifer: _____
E-Log #: _____

County: Jones
Permit #: MS-GW-17241
Driller: John W Thompson
Date drilling completed: 10-23-15

State Law requires that this report be prepared by the license holder responsible for the work and filed with the Department at the above address within 30 days of completion of drilling of the well or borehole.

Well Owner Information <small>(Landowner if borehole is not for a water well)</small>	Well or Borehole Location
Owner Name: <u>Matthew Campbell</u>	Latitude: <u>N 31° 29' 26.51"</u> Longitude: <u>W 89° 17' 22.31"</u>
Mailing Address: <u>791 RV Lindley Rd</u> <u>Moselle MS 39459</u>	Method of Lat/Long (check one): Conventional Survey _____ USGS quad _____, Hand-held GPS _____, Survey-grade GPS _____
City _____ State _____ Zip Code _____	<u>NE 1/4 NW 1/4, Sec 15 T 6N R 13W</u>
Telephone No. (____) _____	<u>1</u> Miles <u>SW</u> of <u>Moselle</u> <small>(Distance) (Direction) (Nearest Town)</small>

Well / Borehole Data
Date drilling started: <u>10-19-15</u> Date drilling completed: <u>10-23-15</u> Hole depth: <u>747</u> Hole diameter: <u>10.5</u>
Location of the source of any surface water used for drilling: <u>Existing water well</u>
Method of dosing and volume of Chlorine used in drilling and development: <u>added 10 gallons of bleach</u>
Logs run (circle all applicable): No log run <input type="checkbox"/> <input checked="" type="checkbox"/> Electric <input checked="" type="checkbox"/> Gamma Ray <input type="checkbox"/> Density <input type="checkbox"/> Sonic <input type="checkbox"/> Neutron <input type="checkbox"/> Other: _____
Name of organization running log(s): <u>MDEQ</u>
Purpose of borehole (circle one) <input checked="" type="checkbox"/> Water Well <input type="checkbox"/> Geotechnical/Geological Investigation <input type="checkbox"/> Ground Source Heat Pump <input type="checkbox"/> Seismic Survey <input type="checkbox"/> Other (describe) _____
<i>If drilling is not related to water well construction, skip the remainder of this block</i>


Purpose of Well (circle all applicable): Home <input type="checkbox"/> Industrial <input type="checkbox"/> Public Supply <input type="checkbox"/> Irrigation <input type="checkbox"/> Fish Culture <input type="checkbox"/>
Other (describe): <u>Poultry Farm</u>
If a flowing well, method of flow regulation: Valve _____ Other (describe) _____
Static Water Level: <u>100.5</u> feet [above or below] land surface Date measured: <u>10-23-15</u> <small>(circle one)</small>
Method of measurement (circle one): Steel tape <input type="checkbox"/> Electric tape <input type="checkbox"/> <input checked="" type="checkbox"/> Air line <input type="checkbox"/> Other (describe): _____
Well depth: <u>730</u> Well grouted to a depth of: <u>50</u> feet Type of grout (circle one): Neat Cement <input type="checkbox"/> <input checked="" type="checkbox"/> Bentonite <input type="checkbox"/> Mix _____
Casing length: <u>690</u> feet Casing diameter: <u>6</u> inches Type of casing: <u>PVC Certa Lok 6.9 OD</u>
Screen length: <u>40</u> feet Screen diameter: <u>4</u> inches Type of screen: <u>PVC sch 40 slotted</u>
Screen slot size: <u>.010</u> inches Setting depth: From <u>670-690</u> feet to <u>710-730</u> feet
Type of completion (circle all applicable): Gravel packed <input type="checkbox"/> Underreamed <input type="checkbox"/> Open hole <input type="checkbox"/> <input checked="" type="checkbox"/> Natural Development
Other (describe): _____
Top of lap pipe or reduction in casing: _____ feet
<i>If telescoped or more than one screen, describe on next page</i>

County: Jones
 Permit #: MS GW 17241

For Office Use Only:
 Well #: 1121

The sketch below only required for water wells

If well telescopes, show depths on sketch.

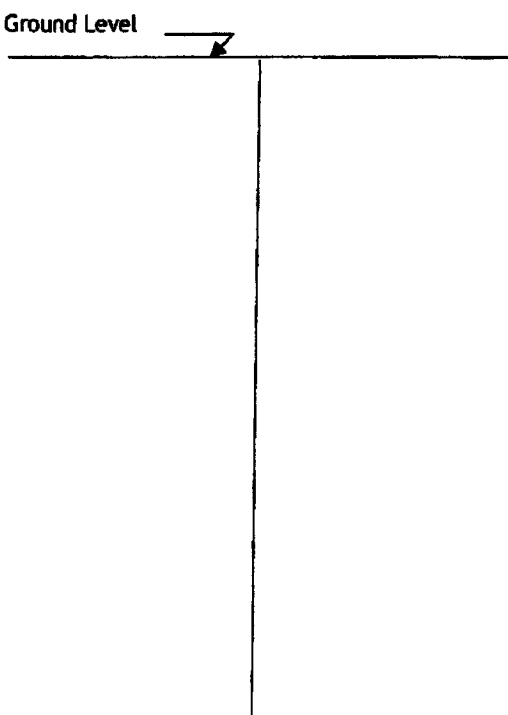

Description of formations encountered must be provided for all wells and boreholes, unless specifically exempted by regulations

Description of Formations Encountered	From (depth)	To (depth)
Clay	Ground level	10
sand & gravel	10	30
Clay	30	190
sand	190	300
Clay	300	400
clay & fine sand	400	440
sand	440	500
Clay	500	600
clay	600	670
sand	670	690
sandy clay	690	710
sand	710	730
clay	730	747

If more than one screen, show location of each on sketch

Sketch the property layout and include the following:
 1) the well location
 2) any permanent structures on the property that may aid in locating the well
 3) any roads, power lines, or other items that may aid in locating the property and the well
 4) north arrow

Landowner Name: Matthew Campbell

I HEREBY CERTIFY that the well/borehole was drilled, constructed, and completed in accordance with all applicable requirements of the Mississippi Department of Environmental Quality and the Mississippi Department of Health regulations, if applicable, and state laws.

John W Thompson 0-679 11-2-15 John W Thompson
 Print Name of Responsible Licensee and License No. Date Signature of Licensee

STATE WELL REPORT

Part 2

Pump Installer's Completion Report
 Mississippi Department of Environmental Quality
 Office of Land and Water Resources
 P.O. Box 2309
 Jackson, MS 39225-2309
 (601)961-5210
 (601) 360-0535 (fax)

For Office Use Only:

Well #: N120

Aquifer: _____

County: James Overt
 Permit #: MS GW 17241
 Driller: John W Thompson
 Date completed: _____

Copy information from block on Part 1

This part of the report must be completed by a licensed water well contractor or a licensed pump installer. A copy of Part 1 of the report must be attached and both parts filed with the Department at the above address within 30 days of well completion.

Well Owner Information	Well Location
Owner Name: <u>Matthew Campbell</u>	Latitude: <u>31° 29' 26.51"</u> Longitude: <u>89° 17' 22.31"</u>
Mailing Address: <u>791 RV Lindley rd</u> <u>Moselle MS 39459</u>	Method of Lat/Long (check one): Conventional Survey _____ USGS quad _____, Hand-held GPS _____, Survey-grade GPS _____
City _____ State _____ Zip Code _____	<u>NE 1/4 NW 1/4, Sec 15 T 6N R 13W</u>
Telephone No. (____) _____	<u>1</u> Miles <u>SW</u> of <u>Moselle</u> (Distance) (Direction) (Nearest Town)

Pump Type (circle one)

Submersible Turbine Air Lift Centrifugal Flowing Well Jet Piston Rotary Other (describe): _____

Date Pump Installed: 11-13-15 Rated Pump Capacity: 130 Gallons Per Minute

Is This Pump (circle one): New Repaired Replacement

Power Type (circle one)

Electric Diesel Gasoline Natural Gas Tractor PTO Windmill Other (describe): _____

Horse Power Rating of Motor: 10 hp Setting Depth: 168 feet Number of Stages: _____

Pump Test Data for Non Flowing Well

Date Well Tested: 10-23-15 Duration of Pump Test (minimum 4 hours): 4 hours

Static Water Level (A): 100 Feet Below Land Surface Pumping Water Level (B): 118 Feet Below Land Surface

Drawdown [(B) - (A)]: 18 Feet Below Land Surface Test Pumping Rate: 120 Gallons Per Minute

Method of measurement (circle one): Steel tape Electric tape Air line Other (describe): _____

Pump Test Data for Flowing Well

Measured shut in head: _____ feet.

Well yielded _____ GPM with a drawdown of _____ feet after _____ hours of pumping

Meter Installation

Meter Manufacturer: _____ Meter Serial Number: _____

Meter Model Number/Name: _____ Type of Meter: _____

Totalizer Register Unit and Multiplier Factor (AF x .001, gal x 1000, etc): _____

Installation Date: _____ Meter installed by: _____

Is This Meter (circle one): New Repaired Replacement

Important: By submitting the above information you are certifying that this meter was installed to manufacturer standards. For agricultural wells, a list of approved meters is on the MDEQ website.

I HEREBY CERTIFY that the above statements are true to the best of my knowledge.

John W Thompson 0-679 11-19-15 John W Thompson
 Print Name of Pump Installer and License No. (if applicable) Date Signature of Pump Installer