

STATE WELL REPORT

Part 1

Driller's Log

Mississippi Department of Environmental Quality
 Office of Land and Water Resources
 P.O. Box 2309
 Jackson, MS 39225-2309
 (601)961-5210
 (601)360-0535 (fax)

For Office Use Only:

Well #: N 128
 Aquifer: _____
 E-Log #: _____

County: Covington Jones
 Permit #: _____
 Driller: James M. Wells
 Date drilling completed: 5-22-19

State Law requires that this report be prepared by the license holder responsible for the work and filed with the Department at the above address within 30 days of completion of drilling of the well or borehole.

Well Owner Information (Landowner if borehole is not for a water well)	Well or Borehole Location
Owner Name: <u>Boleware Farms</u>	Latitude: <u>31° 30.33' N</u> Longitude: <u>89° 23.49' W</u>
Mailing Address: _____	Method of Lat/Long (check one): Conventional Survey _____
<u>383 Riels Rd.</u>	USGS quad _____, Hand-held GPS _____, Survey-grade GPS _____
<u>Seminary</u> <u>MS</u> <u>39479</u>	<u>SW</u> ¼ <u>SW</u> ¼, Sec <u>10</u> T <u>6N</u> R <u>14W</u>
City State Zip Code	_____ Miles _____ of _____
Telephone No. (____) _____	(Distance) (Direction) (Nearest Town)

Well / Borehole Data

Date drilling started: 5-22-19 Date drilling completed: 5-22-19 Hole depth: 140 Hole diameter: 7 1/2"

Location of the source of any surface water used for drilling: Spanning creek

Method of dosing and volume of Chlorine used in drilling and development: granule chlorine

Logs run (circle all applicable): No log run Electric Gamma Ray Density Sonic Neutron Other: _____

Name of organization running log(s): _____

Purpose of borehole (circle one): Water Well Geotechnical/Geological Investigation Ground Source Heat Pump
 Seismic Survey Other (describe) _____

If drilling is not related to water well construction, skip the remainder of this block

RECEIVED
 AUG 08 2019
 BY OLWR

Purpose of Well (circle all applicable): Home Industrial Public Supply Irrigation Fish Culture
 Other (describe): chicken house

If a flowing well, method of flow regulation: Valve _____ Other (describe) _____

Static Water Level: 70 feet [above or below land surface (circle one)] Date measured: 5-22-19

Method of measurement (circle one): Steel tape Electric tape Air line Other (describe): _____

Well depth: 140 Well grouted to a depth of: 10 feet Type of grout (circle one): Neat Cement Bentonite Mix

Casing length: 120 feet Casing diameter: 4 inches Type of casing: pvc

Screen length: 20 feet Screen diameter: 4 inches Type of screen: pvc

Screen slot size: .008 inches Setting depth: From 120 feet to 140 feet

Type of completion (circle all applicable): Gravel packed Underreamed Open hole Natural Development

Other (describe): _____


Top of lap pipe or reduction in casing: _____ feet

If telescoped or more than one screen, describe on next page

County: Covington
 Permit #: _____

For Office Use Only:
 Well #: _____

The sketch below only required for water wells
If well telescopes, show depths on sketch.

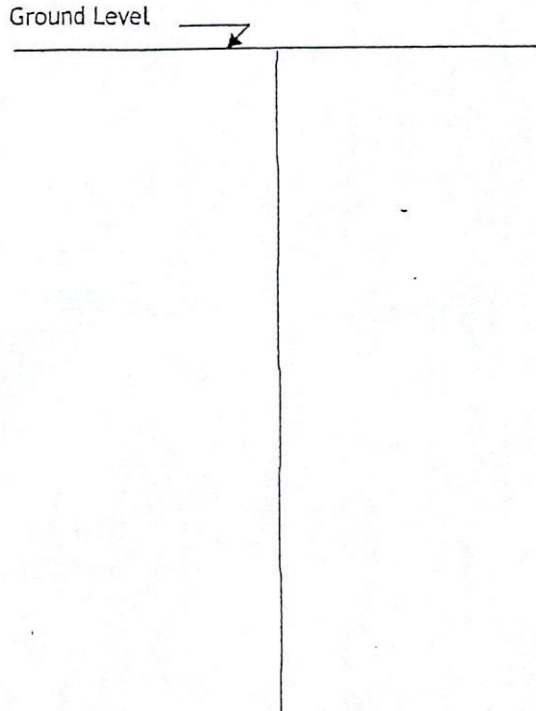


Description of formations encountered must be provided for all wells and boreholes, unless specifically exempted by regulations

Description of Formations Encountered	From (depth)	To (depth)
	Ground level	1
clay soil		
clay	1	115
sand	115	140

If more than one screen, show location of each on sketch

- Sketch the property layout and include the following:
- 1) the well location
 - 2) any permanent structures on the property that may aid in locating the well
 - 3) any roads, power lines, or other items that may aid in locating the property and the well
 - 4) north arrow

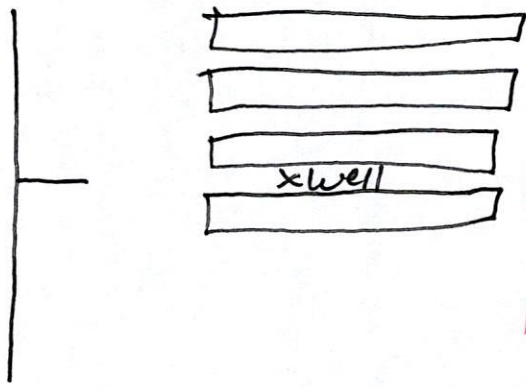

RECEIVED
 AUG 08 2019
 BY OLW.13

Landowner Name: Boleware Farm

I HEREBY CERTIFY that the well/borehole was drilled, constructed, and completed in accordance with all applicable requirements of the Mississippi Department of Environmental Quality and the Mississippi Department of Health regulations, if applicable, and state laws.

James M. Wells 00005889 8-5-19 James M. Wells
 Print Name of Responsible Licensee and License No. Date Signature of Licensee

STATE WELL REPORT

Part 2

Pump Installer's Completion Report
Mississippi Department of Environmental Quality
Office of Land and Water Resources
P.O. Box 2309
Jackson, MS 39225-2309
(601)961-5210
(601) 360-0535 (fax)

County: Covington Jones
Permit #:
Driller: James M. Wells
Date completed: 5.22.19
Copy information from block on Part 1

For Office Use Only:
Well #: N 128
Aquifer:

This part of the report must be completed by a licensed water well contractor or a licensed pump installer. A copy of Part 1 of the report must be attached and both parts filed with the Department at the above address within 30 days of well completion.

Well Owner Information: Owner Name: Boleware Farms, Mailing Address: 383 Riels Rd. Seminary MS 39479, Telephone No.
Well Location: Latitude: 31° 30.33N, Longitude: 89° 23.49W, Method of Lat/Long: Conventional Survey, USGS quad: SW 1/4 SW 1/4, Sec 10 T 6N R 14W

Pump Type (circle one): Submersible, Turbine, Air Lift, Centrifugal, Flowing Well, Jet, Piston, Rotary, Other (describe):
Date Pump Installed: 5.22.19, Rated Pump Capacity: 55 Gallons Per Minute
Is This Pump (circle one): New, Repaired, Replacement

Power Type (circle one): Electric, Diesel, Gasoline, Natural Gas, Tractor PTO, Windmill, Other (describe):
Horse Power Rating of Motor: 5, Setting Depth: 100 feet, Number of Stages: 13

Pump Test Data for Non Flowing Well
Date Well Tested: 5.22.19, Duration of Pump Test (minimum 4 hours): 4 hours
Static Water Level (A): 70 Feet Below Land Surface, Pumping Water Level (B): 100 Feet Below Land Surface
Drawdown [(B) - (A)]: 75 Feet Below Land Surface, Test Pumping Rate: 70 Gallons Per Minute
Method of measurement (circle one): Steel tape, Electric tape, Air line, Other (describe):

Pump Test Data for Flowing Well
Measured shut in head: feet.
Well yielded GPM with a drawdown of feet after hours of pumping

Meter Installation
Meter Manufacturer: Meter Serial Number:
Meter Model Number/Name: Type of Meter:
Totalizer Register Unit and Multiplier Factor (AF x .001, gal x 1000, etc):
Installation Date: Meter installed by:
Is This Meter (circle one): New, Repaired, Replacement
Important: By submitting the above information you are certifying that this meter was installed to manufacturer standards. For agricultural wells, a list of approved meters is on the MDEQ website.

I HEREBY CERTIFY that the above statements are true to the best of my knowledge.
James M. Wells 00005889 8.5.19 James M. Wells
Print Name of Pump Installer and License No. (if applicable) Date Signature of Pump Installer