

N 131

County: Jones
 Permit #: _____
 Driller: James M. Wells
 Date drilling completed: 8-19-21

STATE WELL REPORT

Part 1

Driller's Log

Mississippi Department of Environmental Quality
 Office of Land and Water Resources
 P.O. Box 2309
 Jackson, MS 39225-2309
 (601)961-5210
 (601)360-0535 (fax)

For Office Use Only:
 Well #: _____
 RECEIVED
 Aquifer: _____
 DEC 28 2021
 E-Log #: _____
 BY OLWR

State Law requires that this report be prepared by the license holder responsible for the work and filed with the Department at the above address within 30 days of completion of drilling of the well or borehole.

| | |
|---|---|
| <p>Well Owner Information (Landowner if borehole is not for a water well)</p> <p>Owner Name: <u>Joey Karoly</u> Mailing Address: <u>278 Deik rd.</u> <u>Moselle</u> <u>ms</u> <u>39459</u> City State Zip Code Telephone No. (____) _____</p> | <p>Well or Borehole Location</p> <p>Latitude: <u>31°27'9"N</u> Longitude: <u>89°22'39"W</u> Method of Lat/Long (check one): Conventional Survey _____ USGS quad _____, Hand-held GPS _____, Survey-grade GPS _____ <u>NE</u> ¼ <u>SW</u> ¼, Sec <u>26</u> T <u>6N</u> R <u>14W</u> _____ Miles _____ of _____ (Distance) (Direction) (Nearest Town)</p> |
|---|---|

Well / Borehole Data

Date drilling started: 8-19-21 Date drilling completed: 8-19-21 Hole depth: 120 Hole diameter: 8 in
 Location of the source of any surface water used for drilling: Running Creek Water
 Method of dosing and volume of Chlorine used in drilling and development: granule chlorine
 Logs run (circle all applicable): No log run Electric Gamma Ray Density Sonic Neutron Other: _____
 Name of organization running log(s): _____
 Purpose of borehole (circle one): Water Well Geotechnical/Geological Investigation Ground Source Heat Pump
 Seismic Survey Other (describe) _____
If drilling is not related to water well construction, skip the remainder of this block


Purpose of Well (circle all applicable): Home Industrial Public Supply Irrigation Fish Culture
 Other (describe): _____
 If a flowing well, method of flow regulation: Valve _____ Other (describe) _____
 Static Water Level: 55 feet [above or below land surface] (circle one) Date measured: 8-19-21
 Method of measurement (circle one): Steel tape Electric tape Air line Other (describe): _____
 Well depth: 120 Well grouted to a depth of: 10 feet Type of grout (circle one): Neat Cement Bentonite Mix
 Casing length: 100 feet Casing diameter: 4 inches Type of casing: PVC
 Screen length: 20 feet Screen diameter: 4 inches Type of screen: PVC
 Screen slot size: .008 inches Setting depth: From 100 feet to 120 feet
 Type of completion (circle all applicable): Gravel packed Underreamed Open hole Natural Development
 Other (describe): _____
 Top of lap pipe or reduction in casing: _____ feet
If telescoped or more than one screen, describe on next page

County: Jones
Permit #: _____

For Office Use Only:
Well #: _____

The sketch below only required for water wells
If well telescopes, show depths on sketch.


Description of formations encountered must be provided for all wells
and boreholes, unless specifically exempted by regulations

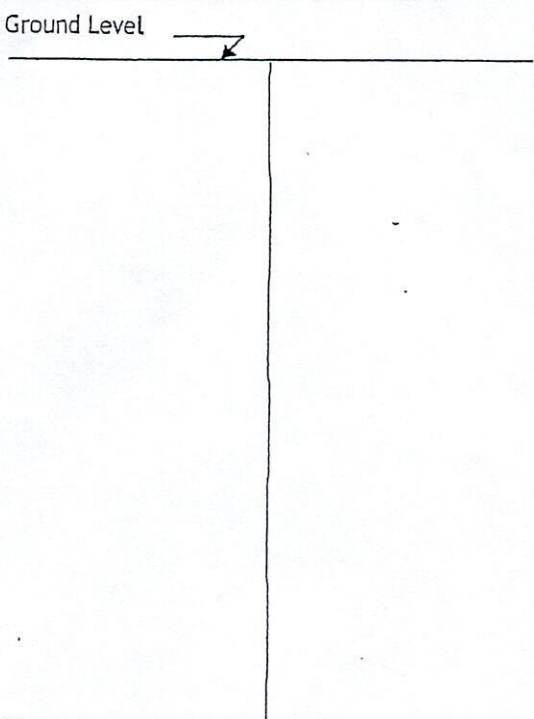

| Description of Formations Encountered | From (depth) | To (depth) |
|---------------------------------------|--------------|------------|
| | Ground level | |
| top soil | 0 | 2 |
| clay/sand | 2 | 70 |
| sand | 70 | 120 |
| | | |
| | | |
If more than one screen, show location of each on sketch

- Sketch the property layout and include the following:
- 1) the well location
 - 2) any permanent structures on the property that may aid in locating the well
 - 3) any roads, power lines, or other items that may aid in locating the property and the well
 - 4) north arrow

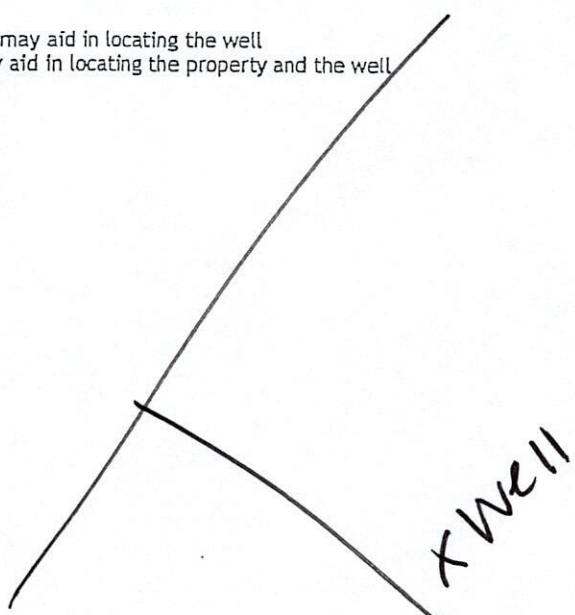

Landowner Name: _____

I HEREBY CERTIFY that the well/borehole was drilled, constructed, and completed in accordance with all applicable requirements of the Mississippi Department of Environmental Quality and the Mississippi Department of Health regulations, if applicable, and state laws.

James M. Wells 00005889
Print Name of Responsible Licensee and License No.

8-19-21
Date

James M. Wells
Signature of Licensee

STATE WELL REPORT

Part 2

Pump Installer's Completion Report
Mississippi Department of Environmental Quality
Office of Land and Water Resources
P.O. Box 2309
Jackson, MS 39225-2309
(601)961-5210
(601) 360-0535 (fax)

County: Jones
Permit #: _____
Driller: James M. Wells
Date completed: 8-19-21
Copy information from block on Part 1

For Office Use Only:
Well #: N 131
Aquifer: _____

This part of the report must be completed by a licensed water well contractor or a licensed pump installer. A copy of Part 1 of the report must be attached and both parts filed with the Department at the above address within 30 days of well completion.

| Well Owner Information | | | Well Location | | |
|---------------------------------------|---|------------------------------|---------------|--|--|
| Owner Name: <u>Joey Karoly</u> | Latitude: <u>31°27'9"N</u> | Longitude: <u>89°22'39"W</u> | | | |
| Mailing Address: <u>278 Deik rd.</u> | Method of Lat/Long (check one): Conventional Survey _____, USGS quad _____, Hand-held GPS _____, Survey-grade GPS _____ | | | | |
| <u>Moselle</u> <u>MS</u> <u>39459</u> | <u>NE</u> ¼ <u>SW</u> ¼, Sec <u>26</u> T <u>6N</u> R <u>14W</u> | | | | |
| City State Zip Code | _____ Miles _____ of _____ (Distance) (Direction) (Nearest Town) | | | | |
| Telephone No. (____) _____ | | | | | |

Pump Type (circle one)
 Submersible Turbine Air Lift Centrifugal Flowing Well Jet Piston Rotary Other (describe): _____
Date Pump Installed: 8-19-21 Rated Pump Capacity: 10 Gallons Per Minute
Is This Pump (circle one): New Repaired Replacement

Power Type (circle one)
 Electric Diesel Gasoline Natural Gas Tractor PTO Windmill Other (describe): _____
Horse Power Rating of Motor: 1hp Setting Depth: 90 feet Number of Stages: 15

Pump Test Data for Non Flowing Well
Date Well Tested: 8-19-21 Duration of Pump Test (minimum 4 hours): 4 hours
Static Water Level (A): 55 Feet Below Land Surface Pumping Water Level (B): 70 Feet Below Land Surface
Drawdown [(B) - (A)]: 15 Feet Below Land Surface Test Pumping Rate: 10 Gallons Per Minute
Method of measurement (circle one): Steel tape Electric tape Air line Other (describe): _____

Pump Test Data for Flowing Well
Measured shut in head: _____ feet.
Well yielded _____ GPM with a drawdown of _____ feet after _____ hours of pumping

Meter Installation
Meter Manufacturer: _____ Meter Serial Number: _____
Meter Model Number/Name: _____ Type of Meter: _____
Totalizer Register Unit and Multiplier Factor (AF x .001, gal x 1000, etc): _____
Installation Date: _____ Meter installed by: _____
Is This Meter (circle one): New Repaired Replacement
Important: By submitting the above information you are certifying that this meter was installed to manufacturer standards. For agricultural wells, a list of approved meters is on the MDEQ website.

I HEREBY CERTIFY that the above statements are true to the best of my knowledge.
James M. Wells 00005889 8-19-21 James M. Wells
Print Name of Pump Installer and License No. (if applicable) Date Signature of Pump Installer