


JONES
N 2006
11/25/80
11-25

MISSISSIPPI
BOARD OF WATER COMMISSIONERS
416 North State Street
Jackson, Mississippi 39201

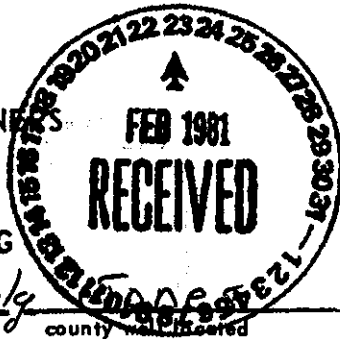

WATER WELL DRILLERS LOG

1980 Roy V. West Drly firm name county Madison

LANDOWNER:	description of formations encountered	from	to
RAY Price	SAND	0	2.3
RT 1 Mosell (mailing address)	CLAY	2.3	150
	SAND	150	180
			14c
WELL LOCATION:			
sec. 33 T 6 N R 13 E 15 miles SW of Ellisville (distance) (direction) (nearest town)			
WELL PURPOSE: HOME (home, irrigation, municipal, industrial)			
WELL COMPLETION DATA:			
(1) diameter (inches) 2"			
(2) total depth (feet) 180'			
(3) static water level (feet) 30' below top of ground.			
(4) casing PVC, 175' depth (material) (depth)			
(size) If telescope see back.			
(5) screen 5' 175' (length) (depth to top)			
2" PVC (size) (material)			
(6) pump 1 15 (HP) (yield gpm)			
REA (type power)			
(7) electric log NO (yes or no)			
(organization running log)			
(8) how well bottom plugged WASH VALVE			
DRILLERS REMARKS:			

DEPT. OF NATURAL RESOURCES
BUREAU OF LAND & WATER RESOURCES

