

MISSISSIPPI DEPARTMENT OF ENVIRONMENTAL QUALITY

Office of Land and Water Resources

P. O. Box 10631
Jackson, MS 39289-0631
WATER WELL DRILLERS LOG

COUNTY WELL LOCATED JONES	
WELL NUMBER N 7013	CODED
DATE WELL COMPLETED 10/26/93	

PERMIT NUMBER 305
NAME OF DRILLING FIRM CHAR'S WELL SER
BUCKATUNGA MS

NAME & MAILING ADDRESS OF LANDOWNER CHARLES DUNAWAY			
RT. 1 BOX 401			
LAUREL, MS 39448			
WELL LOCATION	SEC	TOWNSHIP	RANGE
	16	6	13
DISTANCE	DIRECTION	NEAREST TOWN	
OTHER LANDMARK ON RIVER			
WELL PURPOSE: Home, Irrigation, Municipal, Industrial, Fish Pond, etc. CAMP			

PUMP DATA		
PUMP TYPE (Circle One): <input checked="" type="checkbox"/> Submersible Turbine Jet Flowing Well, Other (Describe) _____		
POWER TYPE (Circle One): <input checked="" type="checkbox"/> Electric Tractor Diesel Gasoline Butane, Other (Describe) _____ H/P 2		
Pump Capacity (GPM) 10	No of Stages 8	Setting Depth 120 FT.
PUMP TEST		
Well yielded 12 GPM with a drawdown of 0 ft. after 2 hours of pumping		


WELL DATA		
Well Depth 123	Casing Diameter (In.) 4	Casing Length (Ft.) 128
Type of Casing PVC	Hole Depth 123	Depth to Static Water Level 38
TYPE OF COMPLETION: (Circle One or More): <input checked="" type="checkbox"/> Gravel Packed <input type="checkbox"/> Underreamed <input type="checkbox"/> Telescoped, <input checked="" type="checkbox"/> Natural Development <input type="checkbox"/> Open Hole <input type="checkbox"/> Other (Describe)		
WELL GROUTED TO A DEPTH OF 20 FEET Type Grout (circle one): Cement, Bentonite, or Mix		

LOG DATA	
TYPE OF LOG RUN (Circle One): <input type="checkbox"/> No Log Run, <input type="checkbox"/> Electric, Gamma Ray, Density, Sonic, Neutron, Other (Describe) _____	
Name of Organization Running Log	

SCREEN DATA		
Diameter - Inches 4	Length - Feet 5	Slot Size - Inches 6
Screen Type PVC	Depth to Bottom - Feet 123	

GEOLOGIC DATA (Office Use Only)			
Surface Elev.	Geologic Unit	Unit Thickness	Depth to Top
Subs. SWL	Date	Analysis	Aquifer Test
Driller's Remarks B.W.V. NOT PLUS			
Top of Lap Pipe or Reduction in Casing			
FEET IF TELESCOPED OR MORE THAN ONE SCREEN: USE BACK PAGE			

DESCRIPTION OF FORMATIONS ENCOUNTERED	FROM	TO	FORMATIONS (Continued)	FROM	TO
TOP SOIL	0	1	TAPE CLAY	96	115
Y. WH. SD.	1	20	BRN SD. & CLAY	115	127
MED. DH. SD.	20	26	MED. WH. SD	127	133
PK. GR. CLAY	26	35			
Y. SD.	35	36			
BOCK	36	37			
GR. CLAY	37	53			
PK. CLAY	53	62			
Y. SP.	62	63			
PK. GR. CLAY	63	69			
GRAY CLAY	69	99			

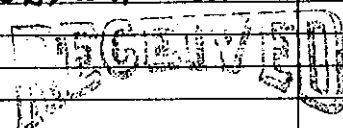

NOV 19 1993