

JONES

MISSISSIPPI BOARD OF WATER COMMISSIONERS

WATER WELL DRILLERS LOG

Date: 7-7, 1962, Driller: Hermon Parker County Jones


(1) Owner of Land: J.A. Hyltes (Name)
R.I. Mosselle (Address)
(2) Location: 1/4, 1/4, Sec. 7 T6 N R12 W, 2 miles East of Mosselle
(3) Topography: Hilly
(4) Purpose of Well: Domestic

Table with 4 columns: Description & Color of Materials, Thickness Feet, Depth Feet. Rows include Mud Clay (20 ft), Chert (59 ft), and Sand (26 ft).

Information upon completion of well:

(1) Diameter: 2 inches.
(2) Total Depth: 105 feet.
(3) Water Level: 58 feet below top of ground.
(4) Cased to: 105, Size 2"
(5) Screen: Size 2", Length 5'
(6) Were any formations sealed against pollution? yes, 1 no.

If YES depth of formation
Why
Drillers Remarks:

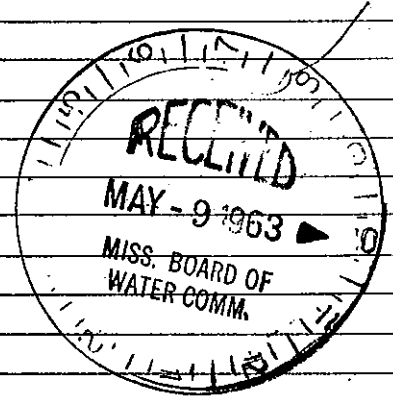

105
47 Well No.

(Use Back Side)

Mail this copy to Board of Water Commissioners 429 Miss. St. Jackson, Mis