

MISSISSIPPI BOARD OF WATER COMMISSIONERS

JONES

04

WATER WELL DRILLERS LOG

12-26-62

Date: 12-26, 1962, Driller: M. M. Moore's County Fannin
Chuck Moore Moore's Well Drilling Service

| (1) Owner of Land: | Description & Color of Materials Sand, Clay, Red Clay, Shell, etc. | Thick- ness Feet | Depth Feet |
|---|---|------------------------|---------------|
| <u>R. G. Harrington</u> <small>(Name)</small> <u>RT 5, Box 283, Hattiesburg, Miss</u> <small>(Address)</small> | <u>Service 0</u> | <u>10</u> | |
| | <u>Gravel 10</u> | <u>5'8"</u> | |
| (2) Location: <u>1/4, 1/4, Sec. 16 T6 R13W</u> | | | |
| <u>10</u> miles <u>NE</u> , of <u>Hattiesburg</u> <small>(distance) (direction) (Nearest Town)</small> | | | |
| (3) Topography: _____ <small>(Hilly) (Flat) (Level)</small> | | | |
| (4) Purpose of Well: <u>all Purpose</u> <small>(Domestic Irrigation, Municipal, Industrial, Other)</small> | | | |


Information upon completion of well:

- (1) Diameter 2" inches.
- (2) Total Depth 5'8" feet.
- (3) Water level 3'8" feet below top of ground.
- (4) Cased to 32', Size 1"
- (5) Screen: Size 2", Length 6"
- (6) Were any formations sealed against pollution?
 yes, no.

If YES depth of formation _____

Why _____

Drillers Remarks: set sit at
48 feet. Plenty
water
check w/ your purpose

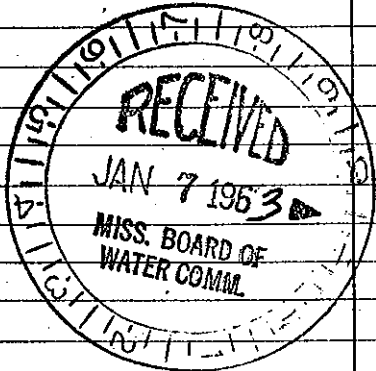

Well No. 9

(Use Back Side)