

MISSISSIPPI BOARD OF WATER COMMISSIONERS

WATER WELL DRILLERS LOG

Jones
 ③ 05
 11-66

Date: 11-4, 1966, Driller: J & R Drilling Ser County Precheur

(1) Owner of Land: John A. Jones
 (Name)
Route 2 Ellisville Miss
 (Address)

(2) Location: NE 1/4, SW 1/4, Sec. 29 T6N R12W
6 miles East of Easton
 (distance) (direction) (Nearest Town)

(3) Topography: Hilly
 (Hilly) (Flat) (Level)


(4) Purpose of Well: Hand
 (Domestic Irrigation
 Municipal, Industrial, Other)

Description & Color of Materials Sand, Clay, Red Clay, Shell, etc.	Thick- ness Feet	Depth Feet
Red clay	10	10
1/2 sand & clay	10	20
Fine sand	10	30
" "	10	40
Gravel	20	60
Fine sand	10	70
Red clay	10	80
Fine sand	20	100
Dark sand	23	123

Information upon completion of well:

- (1) Diameter 2 inches.
- (2) Total Depth 123 feet.
- (3) Water Level 64 feet below top of ground.
- (4) Cased to 128 ft, Size 2"
- (5) Screen: Size 8", Length 5 ft
- (6) Were any formations sealed against pollution?
 _____ yes, no.

If YES depth of formation _____
 Why _____
 Drillers Remarks: _____

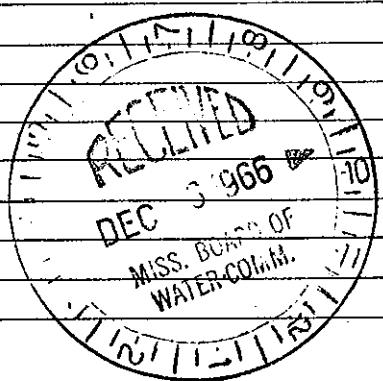

(Use Back Side)

Well No.