

JONES
06
12-67

MISSISSIPPI BOARD OF WATER COMMISSIONERS

WATER WELL DRILLERS LOG

Date: Dec. 14, 1967, Driller: Leamon Thrash County Jones
(Name)

(1) Owner of Land:	Description & Color of Materials Sand, Clay, Red Clay, Shell, etc.	Thick- ness Feet	Depth Feet
<u>Jerry Ainsworth</u> (Name)	<u>Red Sand</u>	<u>38</u>	<u>38</u>
<u>Route 1 Maule, Miss</u> (Address)	<u>White Chalk</u>	<u>114</u>	<u>114</u>
(2) Location: <u>1/4</u> , <u>1/4</u> , Sec. <u>7</u> T. <u>6 R. 12</u>	<u>Sand</u>	<u>30</u>	<u>30</u>
<u>5</u> miles <u>east</u> , of <u>Maule</u> . (distance) (direction) (Nearest Town)		<u>182</u>	<u>182</u>
(3) Topography: <u>hilly</u> (Hilly) (Flat) (Level)			
(4) Purpose of Well: (Domestic Irrigation, Municipal, Industrial, Other)			

Information upon completion of well:

(1) Diameter 2" inches.

(2) Total Depth 180 feet.

(3) Water Level 120 feet below top of ground.

(4) Cased to 175, Size 2"


(5) Screen: Size 2", Length 5'

(6) Were any formations sealed against pollution?
 _____ yes, X no.

If YES depth of formation _____

Why _____

Drillers Remarks: _____

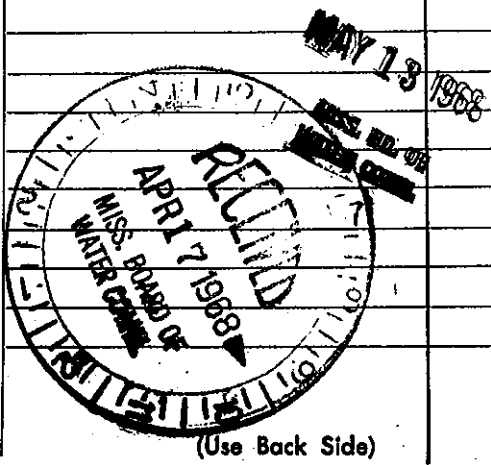

Well No. _____

Mail this copy to Board of Water Commissioners 429 Miss. St. Jackson, Miss.