

Jones  
07  
8-68

MISSISSIPPI  
BOARD OF WATER COMMISSIONERS  
416 North State Street  
Jackson, Mississippi 39201

WATER WELL DRILLERS LOG

8-1 1968 Roy V. West Jones  
date well completed firm name county well located

LANDOWNER: Mr. Richard Blackledge  
Ellisville Rt 3  
Miss  
(mailing address)

Description of formations encountered	from	to
Clay	0	20
sand	20	30
clay	30	200
	<del>200</del>	<del>240</del>
sand	200	240

WELL LOCATION:  
sec. 12 T. 6 N. R. 12 E  
0.8 miles S.E. of Ellisville  
(distance) (direction) (nearest town)

WELL PURPOSE: home  
(home, irrigation, municipal, industrial)

WELL COMPLETION DATA:

(1) diameter (inches) 2 in

(2) total depth (feet) 240

(3) static water level (feet) 80 below top of ground.

(4) casing galv 2  
(material) (depth)  
(size) if telescope see back.


(5) screen 10 130  
(length) (depth to top)  
1/4 st steel  
(size) (material)

(6) pump 1/2 6  
(HP) (yield gpm)  
R.E.A.  
(type power)

(7) electric log no  
(yes or no)

(organization running log)

(8) how well bottom plugged Washed

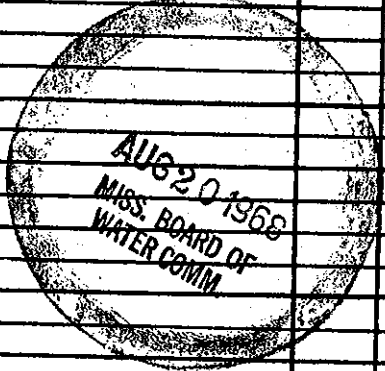

DRILLERS REMARKS: