

JONES MISSISSIPPI BOARD OF WATER COMMISSIONERS


⑥ P/16
9-14-65

WATER WELL DRILLERS LOG

Date: 9/14, 1965, Driller: O. J. Clark County Jones

(Name)

(1) Owner of Land:	Description & Color of Materials Sand, Clay, Red Clay, Shell, etc.	Thick- ness Feet	Depth Feet
A. W. Fisher Rt #1 Outlet Miss (Name) (Address)	0-35 Sand & Gravel	35	
	35-55 Yellow Clay	20	
	55-90 Blue Clay	25	
	80-90 fine Sand	10	
	90-133 Sand	43	
		133	
(2) Location: 1/4, 1/4, Sec. 29 T6 R11W			
4 miles West of Outlet (distance) (direction) (Nearest Town)			
(3) Topography: (Hilly) (Flat) (Level)			
(4) Purpose of Well: Domestic (Domestic Irrigation Municipal, Industrial, Other)			
Information upon completion of well:			
(1) Diameter 2 inches.			
(2) Total Depth 133 feet.			
(3) Water Level 52 feet below top of ground.			
(4) Cased to 123, Size 2 in.			
(5) Screen: Size 1/4, Length 10			
(6) Were any formations sealed against pollution?			
yes, <input checked="" type="checkbox"/> no.			
If YES depth of formation			
Why			
Drillers Remarks:			

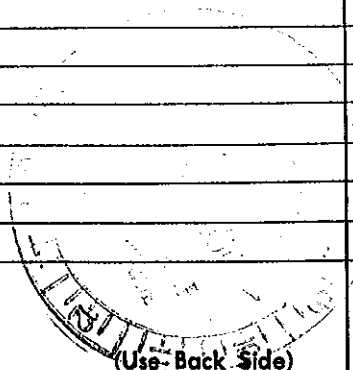

Well No.

Mail this copy to Board of Water Commissioners 429 Miss. St. Jackson, Miss