

MISSISSIPPI BOARD OF WATER COMMISSIONERS

WATER WELL DRILLERS LOG

JONES
3 P17
8-66

Date: 8/1, 1966, Driller: A. W. Tucker County: Jones
(Name)

(1) Owner of Land:	Description & Color of Materials Sand, Clay, Red Clay, Shell, etc.	Thick- ness Feet	Depth Feet
AW Tucker (Name)	0-70 Clay	70	
Rt #1 Quett Miss (Address)	70-80 Sandy Clay	10	
Location: SE 1/4, SW 1/4, Sec. 25 T4N R1W, 6 11	80-150 Clay	80	
4 miles S.W. of Quett (distance) (direction) (Nearest Town)	150-170 fine sand	08	
(3) Topography: (Hilly) (Flat) (Level)	170-200 Sandy Clay	30	
(4) Purpose of Well: Chicken Houses (Domestic Irrigation Municipal, Industrial, Other)	200-210 Sand	05	
	210-232 Clay & Sand	22	
	232-247 Goul Sand	15	


Information upon completion of well:

- (1) Diameter 2 inches.
- (2) Total Depth 247 feet.
- (3) Water Level 90 ft feet below top of ground.
- (4) Cased to 239, Size 2.
- (5) Screen: Size 1 1/4, Length 8 SS.
- (6) Were any formations sealed against pollution?
_____ yes, no.

If YES depth of formation _____

Why _____

Drillers Remarks: _____

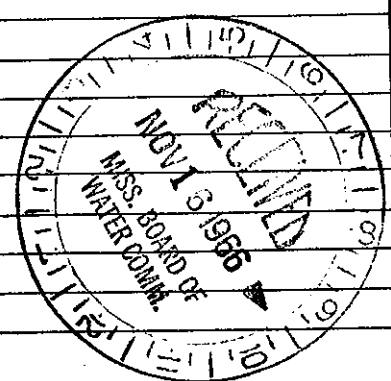

(Use Back Side)

Well No.