

Jones
 (3) P18
 11-67

MISSISSIPPI
 BOARD OF WATER COMMISSIONERS
 416 North State Street
 Jackson, Mississippi 39201

WATER WELL DRILLERS LOG

11.28.1967 Roy V. West Jones
 date well completed firm name county well located


LANDOWNER: Edwin Culpeper
 Orville Miss
 Rt 1
 (mailing address)

description of formations encountered	from	to
Red Clay	0	15
Gray Clay	15	80
ssand	80	85
Blue clay	85	150
green clay	150	380
ssand	380	400

WELL LOCATION:
 sec. 18 T. 6 N. R. 11 E
 8 miles S.E. of Etlinville
 (distance) (direction) (nearest town)

WELL PURPOSE: Chicken house
 (home, irrigation, municipal, industrial)

- WELL COMPLETION DATA:
- (1) diameter (inches) 2
 - (2) total depth (feet) 400
 - (3) static water level (feet) 50 below top of ground.
 - (4) casing galv, 388 (material), (depth), 1 1/4 (size) If telescope see back.
 - (5) screen 12 ft 388 (length), (depth to top), 1 1/4 Brass (size), (material)
 - (6) pump 1 (HP), 8 (yield gpm), Rea (type power)
 - (7) electric log NO (yes or no)
 - (organization running log)
 - (8) how well bottom plugged Washwater

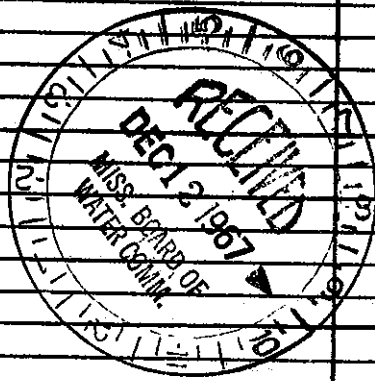

DRILLERS REMARKS: