

Jones  
P 21  
9-20-68

MISSISSIPPI  
BOARD OF WATER COMMISSIONERS  
416 North State Street  
Jackson, Mississippi 39201

CODED

WATER WELL DRILLERS LOG

Sept 20 1968 Zins Drilling Jones  
date well completed firm name county well located

LANDOWNER: Shae Mule

description of formations encountered from to


Ellisville Miss  
(mailing address)

Clay Red 0 74  
Silt 14 20  
Clay Gray 20 31  
Silt 31 81

WELL LOCATION:  
sec. 34 T. 6 S. R. 11 E.  
4 1/2 miles N-NE of Russelton  
(distance) (direction) (nearest town)

WELL PURPOSE: home  
(home, irrigation, municipal, industrial)

- WELL COMPLETION DATA:
- (1) diameter (inches) 2
  - (2) total depth (feet) 81
  - (3) static water level (feet) 40 (below/above top of ground)
  - (4) casing PVC 76  
(material) (depth)  
(size) if telescope see back.
  - (5) screen 5 76  
(length) (depth to top)  
2 PVC  
(size) (material)
  - (6) pump 3/4 5 1/2  
(HP) (yield gpm)  
Electric  
(type power)
  - (7) electric log No  
(yes or no)  
(organization running log)
  - (8) how well bottom plugged Water

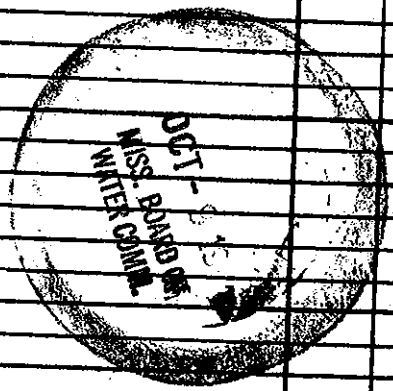

DRILLERS REMARKS: