

JONES

MISSISSIPPI BOARD OF WATER COMMISSIONERS

709
11-64

WATER WELL DRILLERS LOG


Date: Nov., 1964, Driller: Peoples Drilling Co County Jones

(1) Owner of Land:	Description & Color of Materials Sand, Clay, Red Clay, Shell, etc.	Thick- ness Feet	Depth Feet
Ellis A Walley (Name)	yellow clay	12	12
Rt 2 Richton (Address)	white clay + sandy clay	30	42
(2) Location: 1/4, 1/4, Sec. 35 T. 6 N. R. 10 W. January Co line	Blue sandy shale	48	110
7 miles N, of Richton (distance) (direction) (Nearest Town)	yellow gravel	16	126
(3) Topography: Hilly (Hilly) (Flat) (Level)			
(4) Purpose of Well: Home (Domestic Irrigation Municipal, Industrial, Other)			

Information upon completion of well:

- (1) Diameter 2 inches.
- (2) Total Depth 124 feet.
- (3) Water Level 55 feet below top of ground.
- (4) Cased to 120', Size 2"
- (5) Screen: Size 2", Length 4'
- (6) Were any formations sealed against pollution?
yes, no.

If YES depth of formation _____
 Why _____
 Drillers Remarks: _____

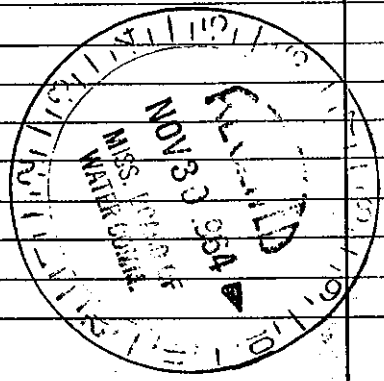

(Use Back Side)

Well No.

Mail this copy to Board of Water Commissioners 429 Miss. St. Jackson, Miss.