

JONES MISSISSIPPI BOARD OF WATER COMMISSIONERS

Q 9

3-23-66 WATER WELL DRILLERS LOG

Date: 3/23, 1966, Driller: C. J. Clark County Jones
(Name)

(1) Owner of Land:	Description & Color of Materials Sand, Clay, Red Clay, Shell, etc.	Thick- ness Feet	Depth Feet
<u>Peter McDonald</u> <small>(Name)</small>	<u>0-27 Clay</u>	<u>22</u>	
<u>Quett Miss</u> <small>(Address)</small>	<u>22-29 fine sand</u>	<u>7</u>	
(2) Location: <u>1/4, 1/4, Sec 16 T6 R10 N</u>	<u>29-261 Blue Clay</u>	<u>232</u>	
<u>2</u> miles <u>East</u> of <u>Quett</u> <small>(distance) (direction) (Nearest Town)</small>	<u>261-290 Sand</u>	<u>29</u>	
(3) Topography: <u>Hilly</u> <small>(Hilly) (Flat) (Level)</small>			
(4) Purpose of Well: <u>Domestic</u> <small>(Domestic Irrigation Municipal, Industrial, Other)</small>			


Information upon completion of well:

- (1) Diameter 2 inches.
- (2) Total Depth 290 feet.
- (3) Water Level 6 feet below top of ground.
- (4) Cased to 280, Size 2 in
- (5) Screen: Size 1/4, Length 10 ft
- (6) Were any formations sealed against pollution?
 yes, no.

If YES depth of formation _____

Why _____

Drillers Remarks: _____

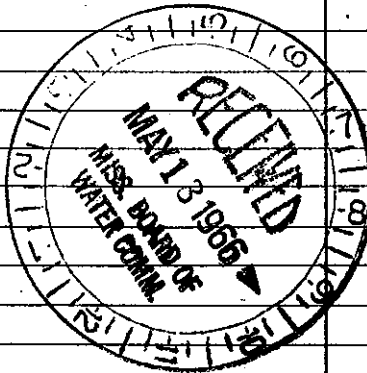

Well No. _____

(Use Back Side)

Mail this copy to Board of Water Commissioners 429 Miss. St. Jackson, Miss.