

Jones
BQ11
10-66

MISSISSIPPI BOARD OF WATER COMMISSIONERS

WATER WELL DRILLERS LOG

Date: Oct, 1966, Driller: People Drilling Co County Jones
(Name)

(1) Owner of Land: <u>B. T. Brown</u>	Description & Color of Materials Sand, Clay, Red Clay, Shell, etc.	Thick- ness Feet	Depth Feet
(Name)	<u>Yellow Clay</u>	<u>21</u>	<u>21</u>
<u>Rt 2 Richton</u>	<u>Yellow sand</u>	<u>8</u>	<u>29</u>
(Address)	<u>Blue clay + small</u>		
(2) Location: <u>SW 1/4, SW 1/4, Sec. 35 T. 6 R. 10</u>	<u>sand streak</u>	<u>34</u>	<u>63</u>
<u>3 7/8</u> miles <u>SE</u> of <u>Onett</u>	<u>Blue sandy shale</u>	<u>252</u>	<u>315</u>
(distance) (direction) (Nearest Town)	<u>shale</u>	<u>21</u>	<u>336</u>
(3) Topography: <u>Hilly</u>	<u>Brown shale</u>	<u>21</u>	<u>357</u>
(Hilly) (Flat) (Level)	<u>Blue sandy shale</u>	<u>42</u>	<u>399</u>
(4) Purpose of Well: <u>Home</u>	<u>White shaly sand</u>	<u>48</u>	<u>447</u>
(Domestic Irrigation Municipal, Industrial, Other)	<u>white sand</u>		


Information upon completion of well:

- (1) Diameter 2 inches.
- (2) Total Depth 447 feet.
- (3) Water Level 92 feet below top of ground.
- (4) Cased to 441', Size 2"
- (5) Screen: Size 2", Length 6'
- (6) Were any formations sealed against pollution?
 yes, no.

If YES depth of formation _____

Why _____

Drillers Remarks: _____

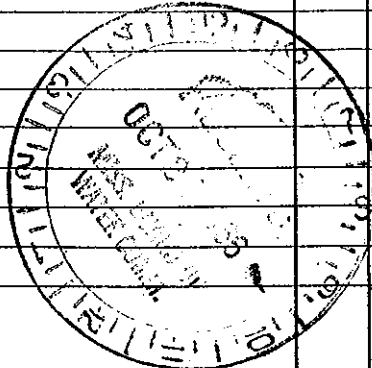

(Use Back Side)

Well No. _____