

MISSISSIPPI BOARD OF WATER COMMISSIONERS

WATER WELL DRILLERS LOG

Date: Oct 1966, Driller: Reuben Perkins Co County Jones

(1) Owner of Land: Joe Taylor (Name)
Rt 2 Jackson (Address)
 Location: SW 1/4, NW 1/4, Sec. 34 T10R10 (Address)
3 1/2 miles SE of Overt (distance)
Hilly (Hilly) (Level)
Home (Municipal, Industrial, Other)
 Purpose of Well: Home

Description & Color of Materials	Thick-ness Feet	Depth Feet
Yellow Sandy clay & sand shales	27	27
Coarse yellow sand + gravel	26	53
Yellow sandy clay	27	80
Gravel & sand yellow	10	90
Yellow sand	10	100

Information upon completion of well:

(1) Diameter 2 inches.

(2) Total Depth 100 feet.

(3) Water Level 66 feet below top of ground.

(4) Cased to 94' Size 2"


(5) Screen: Size 2" Length 6'

(6) Were any formations sealed against pollution? no

If YES depth of formation

Why

Drillers Remarks:

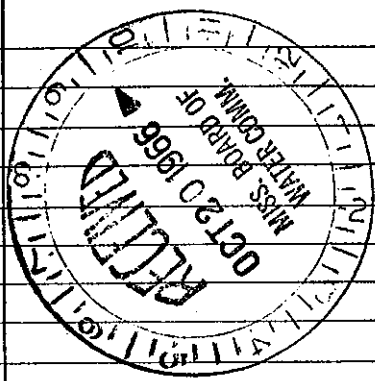

Well No. (Use Back Side)

Mail this copy to Board of Water Commissioners 429 Miss. St. Jackson, Miss.