

MISSISSIPPI BOARD OF WATER COMMISSIONERS

JONES

Check NO.

Jones Co.?

WATER WELL DRILLERS LOG

Q 300

8-31-60

Date: 8/31, 1960, Driller: DAVID NEWELL & SON County: BERRY

(1) Owner of Land: <u>MR WILLIE BRICK</u> (Name)	Description & Color of Materials (Sand, Clay, Red Clay, Shell, etc.)	Thick- ness Feet	Depth Feet
<u>#2, BICHTON, MISS.</u> (Address)	<u>CLAY</u>	<u>0</u>	<u>30</u>
(2) Location: <u>SE 1/4, SE 1/4, Sec 26 T6 R10</u>	<u>SAND</u>	<u>30</u>	<u>50</u>
<u>8</u> miles <u>N</u> of <u>BICHTON</u> (distance) (direction) (Nearest Town)			
(3) Topography: <u>HILLY</u> (Hilly) (Flat) (Level)			
(4) Purpose of Well: <u>DOMESTIC</u> (Domestic Irrigation Municipal, Industrial, Other)			


Information upon completion of well:

- (1) Diameter 4 1/4 inches.
- (2) Total Depth 50 feet.
- (3) Water Level 30 feet below top of ground.
- (4) Cased to 40 ft., Size 2 in.
- (5) Screen: Size 2 in., Length 10 ft.
- (6) Were any formations sealed against pollution?
✓ yes, no.

If YES depth of formation Clay

Why 30 ft. CLAY ON TOP OF WATER

Drillers Remarks:

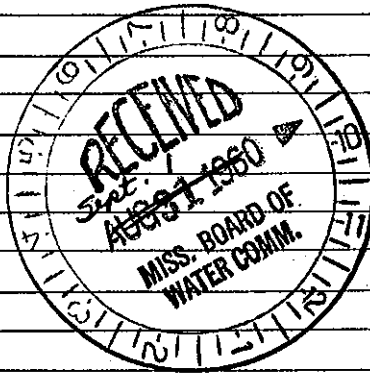

Well No. 9

(Use Back Side)

Mail this copy to Board of Water Commissioners 429 Miss. St. Jackson, Miss.