

JONES

MISSISSIPPI BOARD OF WATER COMMISSIONERS

DQ5

Change NO

WATER WELL DRILLERS LOG

8-17-63

Date: 8/17, 1963, Driller: C.P. Clark County Jones

(Name)

(1) Owner of Land: Clayton Pitts
Rt # 2 Pulten Miss
(Name)
(Address)

Description & Color of Materials Sand, Clay, Red Clay, Shell, etc.	Thick- ness Feet	Depth Feet
0-35 Sandy Clay	35	
35-269 hard Clay	234	

(2) Location: 1/4, 1/4, Sec. 10 T6 N R10 W
3 miles East of Overt
(distance) (direction) (Nearest Town)

(3) Topography: (Hilly) (Flat) (Level)

(4) Purpose of Well: (Domestic Irrigation, Municipal, Industrial, Other)


Information upon completion of well:

- (1) Diameter 2 inches.
- (2) Total Depth 289 feet.
- (3) Water Level 75 feet below top of ground.
- (4) Cased to 279, Size 2 in
- (5) Screen: Size 1 1/4, Length 10
- (6) Were any formations sealed against pollution?
yes, no.

If YES depth of formation

Why

Drillers Remarks:

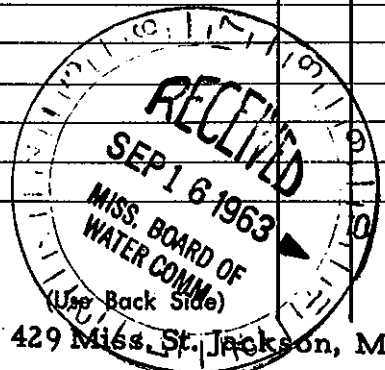

Well No.

Mail this copy to Board of Water Commissioners 429 Miss. St. Jackson, Miss