

MISSISSIPPI BOARD OF WATER COMMISSIONERS

Jones
Q 22
11-3-60

WATER WELL DRILLERS LOG

Count #1169
Jen

Date: 11-3, 1960, Driller: H.H. Baker

County: Jones


(1) Owner of Land: Robert Newell
(Name)
Lawson R 4
(Address)
25 6^N 10^W
(2) Location: 1/4, 1/4, Sec. 6 T. 10 R. 10
18 miles South East of Lawson
(distance) (direction) (Nearest Town)
(3) Topography: (Hilly) (Flat) (Level)
(4) Purpose of Well: Home
(Domestic Irrigation, Municipal, Industrial, Other)

Description & Color of Materials Sand, Clay, Red Clay, Shell, etc.	Depth Feet
Red Clay	33
White "	25
Blue "	40
Sand	25
	122

Information upon completion of well:

(1) Diameter 2 inches.
(2) Total Depth 122 feet.
(3) Water Level 83 feet below top of ground.
(4) Cased to 116, Size 6
(5) Screen: Size 1 1/4, Length 6
(6) Were any formations sealed against pollution?
no

If YES depth of formation _____
Why _____
Drillers Remarks: _____

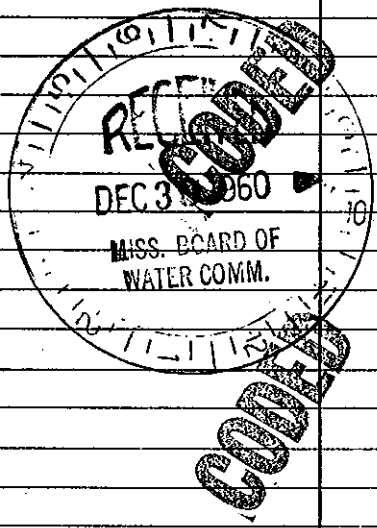

Retain this copy for your office files.

(Use Back Side)

Well No.