

State Well Report

Part I

Mississippi Department of Environmental Quality
Office of Land and Water Resources
P.O. Box 10631
Jackson, MS 39289-0631
(601)961-5210
(601)354-6938 (fax)

County: Jones
 Permit #: _____
 Driller: TRAVIS BOONE
 Date drilling completed: 8-3-04

For Office Use Only:
 Aquifer: _____
 Well #: Q-41
 L. S. Elevation: _____
 B-log #: _____

State Law requires that this report be prepared by the driller in detail and filed with the Department within 30 days of completion of drilling of the well.

Well Owner Information	Well Location
Owner Name: <u>Doug Haigler</u>	Latitude: _____ Longitude: _____
Mailing Address: <u>4000 Hwy 15 S</u> <u>Richmon Mo. 39416</u>	Method of Lat/Long (circle one): <input type="checkbox"/> Conventional Survey, <input type="checkbox"/> USGS quad, <input type="checkbox"/> Hand-held GPS, <input type="checkbox"/> Survey-grade GPS
City: _____ State: _____ Zip Code: _____	<input type="checkbox"/> 1/4 <input type="checkbox"/> 1/4 Sec <u>22</u> Twn <u>6N</u> Rng <u>10W</u>
Telephone No. (601): <u>344-3512</u>	Distance _____ Direction _____ Nearest Town _____ <u>2</u> Miles <u>SE</u> of <u>Overt</u>

Well Data

Purpose of Well (circle one) Home Industrial Public Supply Irrigation Fish Culture Other: _____

Date well drilling started: 8-3-04 Date well drilling completed: 8-3-04

If flowing, method of flow regulation: Valve _____ Other (describe): _____

Static Water Level: 80 ft feet above or below (circle one) land surface Date measured: 8-3-04

Method of Measurement (circle one) reel tape electric tape air line other: string line

Hole depth: 118 Well depth: 118 Well grouted to a depth of 10 feet

Type of grout (circle one): Cement Bentonite Mix

Casing length: 110 feet Casing diameter: 4 inches Type of casing: sch 40

Screen length: 8 feet Screen diameter: 4 inches Type of screen: sch 40

Screen slot size: 8 inches Setting depth: From 110 feet to 118 feet

Type of completion (circle all applicable): Gravel packed Underreamed Telescoped Open hole Natural Development
Other (describe): _____

Top of lap pipe or reduction in casing: _____ feet. If telescoped or more than one screen, describe on back of page

Logs run (circle all applicable): No log run Electric Gamma Ray Density Sonic Neutron Other: _____

Name of organization running log(s): _____

I certify that the well was drilled, constructed, and completed in accordance with all applicable requirements of the Mississippi Department of Environmental Quality and/or the Mississippi Department of Health regulations and state laws.


Travis Boone D-514 Travis Boone
 Print Name of Water Well Contractor and License No. Signature of Water Well Contractor

J and S Water Well Drilling

Q-41


If well telescopes please sketch below and show depths.

Ground Level

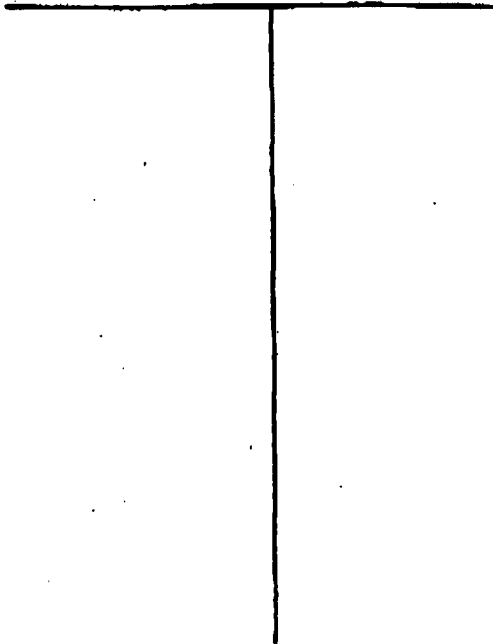

Description of Formations Encountered	From	To
CLAY	0	10
Sand	10	35
CLAY	35	105
Sand	105	118

If more than one screen, show location of each on sketch

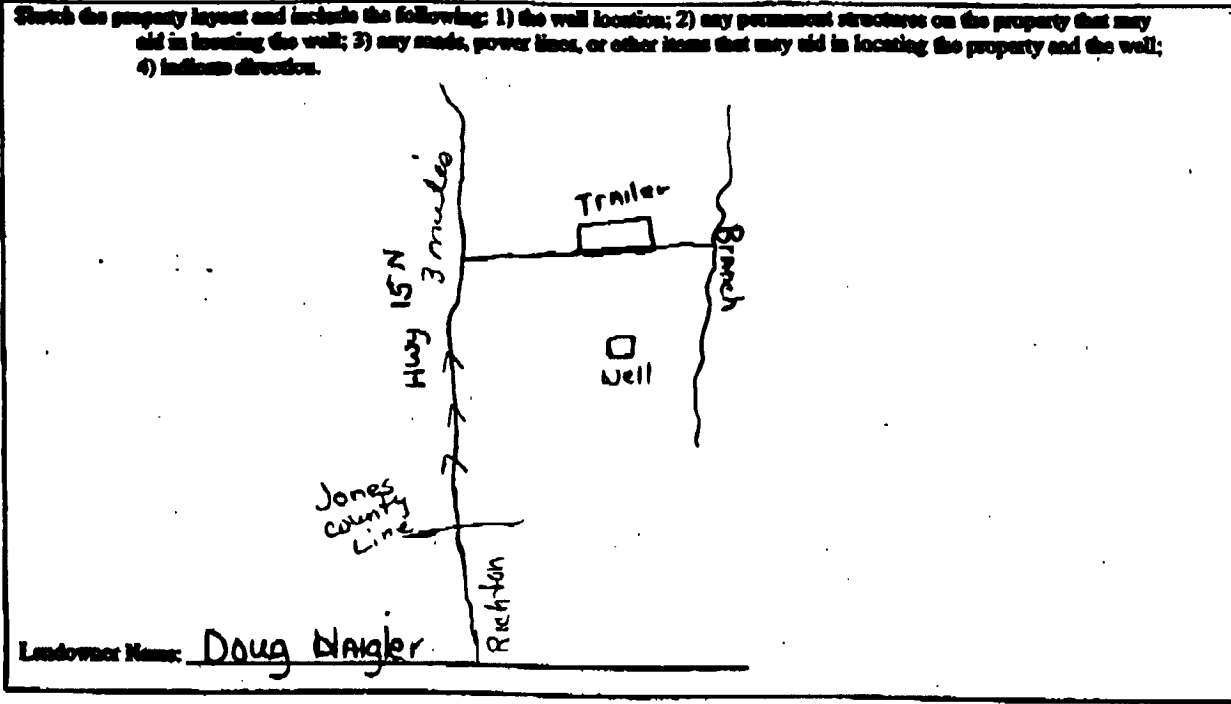

Doug Naigler
 Signature of Water Well Constructor

STATE WELL REPORT

Part 2

Pump Installer's Completion Report
 Mississippi Department of Environmental Quality
 Office of Land and Water Resources
 P.O. Box 10631
 Jackson, MS 39289-0631
 (601)961-5210
 (601)354-6938 (fax)

County: Jones
 Permit #: _____
 Driller: Travis Boone
 Date completed: 8-3-04

For Office Use Only:
 Aquifer: _____
 Well #: Q-41
 Elevation: _____

This report should be prepared by the pump installer in detail and filed with the Department within 30 days of the installation of pump.

Well Owner Information	Well Location
Owner Name: <u>Doug Haigler</u>	Latitude: _____ Longitude: _____
Mailing Address: <u>4000 Hwy 155</u> <u>Richdon, Mo. 39476</u>	Method of Lat/Long (circle one): <u>Conventional Survey</u> USGS quad, Hand-held GPS, Survey-grade GPS
City _____ State _____ Zip Code _____	<u>1/4</u> _____ <u>1/4</u> Sec <u>22</u> Twn <u>6N</u> Rng <u>10W</u>
Telephone No. <u>(601) 344-3512</u>	Distance _____ Direction _____ Nearest Town _____ <u>2</u> Miles <u>SE</u> of <u>Ortt</u>

Pump Type Circle one	Power Type Circle one
Air Lift _____ Jet _____ <u>Submersible</u>	Diesel Engine _____ Gasoline Engine _____ Natural Gas _____
Bucket _____ Piston _____ Turbine _____	<u>Electric Motor</u> _____ Hand _____ Tractor PTO _____
Centrifugal _____ Rotary _____ Flowing Well _____	Windmill _____ Other (specify): _____
Other (specify): _____	Horse Power Rating of Motor: <u>1</u>
Date Pump Installed: <u>8-3-04</u>	Setting Depth: <u>100</u> feet
Rated Pump Capacity: <u>12</u> Gallons Per Minute	Number of Stages: _____

Pump Test Data	Method of Measuring Water Level Circle one
Date Well Tested: <u>8-3-04</u>	Air Line _____ Electric Measuring Line _____ Steel Tape _____
Static Water Level (A): <u>80'</u> Feet Below Land Surface	Other (specify): <u>string line</u>
Pumping Water Level (B): _____ Feet Below Land Surface	For flowing well, measured shut in head: _____ feet
Drawdown ((B) - (A)): _____ Feet Below Land Surface	Well yielded _____ GPM with a drawdown of _____ feet after _____ hours of pumping
Test Pumping Rate: _____ Gallons Per Minute	
Duration of Pump Test (minimum 4 hours): _____ hours	

I HEREBY CERTIFY that the above statements are true to the best of my knowledge.

Travis Boone 0-514
 Print Name of Pump Installer and License No. (if applicable)

Travis Boone
 Signature of Pump Installer