

CODED

MISSISSIPPI
BOARD OF WATER COMMISSIONERS
416 North State Street
Jackson, Mississippi 39201

WATER WELL DRILLERS LOG

Kemper
A 4
4-67

April 10 1967 Ogletree Drilling Kemper
date well completed firm name county well located

LANDOWNER: Johnnie Fox

description of formations encountered

from to

Rt. 1 Preston, Miss.

R²d Clay 0 15
Red and White Sand 15 69

(mailing address)


WELL LOCATION:

sec. 20 T 12 N R 14 E
S W
6 miles S.W. of Preston
(distance) (direction) (nearest town)

WELL PURPOSE: Home Use
(home, irrigation, municipal, industrial)

WELL COMPLETION DATA:

- (1) diameter (inches) 2"
- (2) total depth (feet) 69
- (3) static water level (feet) 28 below above top of ground.
- (4) casing Gav. 63
(material) (depth)
(size) if telescope see back.
- (5) screen 6' 63
(length) (depth to top)
1 1/2 Stainless Steel
(size) (material)
- (6) pump 3/4 9
(HP) (yield gpm)
REA
(type power)
- (7) electric log No
(yes or no)
(organization running log)
- (8) how well bottom plugged
Plugged

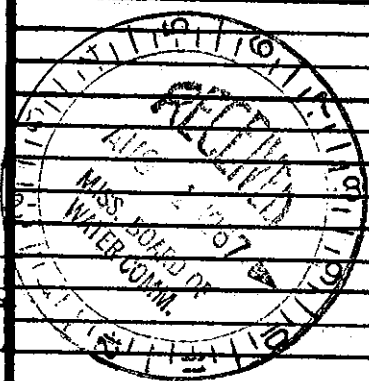

DRILLERS REMARKS: