

KEMPER MISSISSIPPI BOARD OF WATER COMMISSIONERS

A6 CODED

WATER WELL DRILLERS LOG

Cont  
Number  
Kemper  
Winston

Date: 8-24, 1960, Driller: J. H. McDonald County Winston  
(Name)

(1) Owner of Land: Lester McDonald  
(Name)  
Preston, Miss  
(Address)  
(2) Location: 21 12 14  
1/4, 1/4, Sec. T R  
(distance) 4 miles S.W. of Preston  
(direction) (Nearest Town)  
(3) Topography: Hilly  
(Hilly) (Flat) (Level)  
(4) Purpose of Well: Domestic  
(Domestic Irrigation  
Municipal, Industrial, Other)

Description & Color of Materials Sand, Clay, Red Clay, Shell, etc.	Thick- ness Feet	Depth Feet
Red clay	30'	30'
Blue clay	70'	100'
sand & rock	50'	150'


Information upon completion of well:

(1) Diameter: 2 inches.  
(2) Total Depth: 150 feet.  
(3) Water Level: 100 feet below top of ground.  
(4) Cased to 138, Size 2"  
(5) Screen: Size 60 gr.; Length 6'  
(6) Were any formations sealed against pollution?  
yes, no no.

If YES depth of formation

Why

Drillers Remarks: This Well has  
30' of good white  
water sand

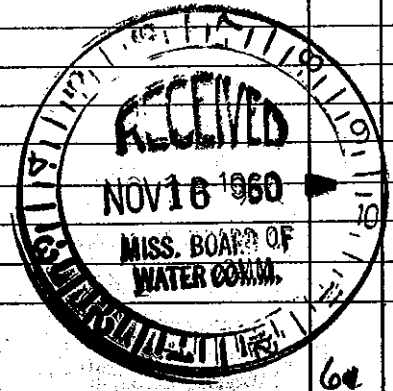

(Use Back Side)

Well No. 60