

KEMPER  
A 7

MISSISSIPPI BOARD OF WATER COMMISSIONERS  
CODED

WATER WELL DRILLERS LOG

11-28-60

Date: Dec. 28, 1960, Driller: L. K. Merritt County Neshoba

(Name)

(1) Owner of Land: ETHEL COPELAND  
(Name)  
PRESTON, MISS  
(Address)

(2) Location: 7 1214  
1/4, 1/4, Sec. T R

20 miles EAST, of Philadelphia  
(distance) (direction) (Nearest Town)

(3) Topography:  (Hilly)  (Flat)  (Level)

(4) Purpose of Well: DOMESTIC  
(Domestic Irrigation  
Municipal, Industrial, Other)

Description & Color of Materials Sand, Clay, Red Clay, Shell, etc.	Thick- ness Feet	Depth Feet
<u>Surge clay</u>	<u>0</u>	<u>10</u>
<u>Red sand</u>	<u>10</u>	<u>20</u>
<u>White Clay + sand</u>	<u>24</u>	<u>40</u>
<u>Fine sand clay</u>	<u>40</u>	<u>70</u>
<u>Trace of clay</u>		
<u>Fine tan sand</u>	<u>10</u>	<u>84</u>
<u>4" Rock at 84</u>		
<u>Blue Marl below</u>		
<u>Rock at 85'</u>		

Information upon completion of well:

(1) Diameter 2 inches.

(2) Total Depth 85 feet.

(3) Water Level 32 feet below top of ground.

(4) Cased to 76, Size 2


(5) Screen: Size 1/4", Length 6'

(6) Were any formations sealed against pollution?  
 yes,  no.

If YES depth of formation 75'

Why Shale Trap

Drillers Remarks:

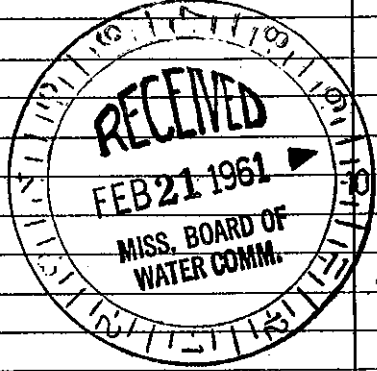

Well No.

(Use Back Side)

Mail this copy to Board of Water Commissioners 429 Miss. St. Jackson, Miss.