

KEMPER MISSISSIPPI BOARD OF WATER COMMISSIONERS

BA10 CODED

6-26-62

WATER WELL DRILLERS LOG

Date: 6/26/67, Driller: L. K. Merrill County Kemper
(Name)

(1) Owner of Land: C. E. Hicks
(Name)
Durston, Mass.
(Address)

(2) Location: 1/4, 1/4, 10, 12, 14
T R
44 miles S/E, of Durston
(distance) (direction) (Nearest Town)

(3) Topography: (Hilly) (Flat) (Level)

(4) Purpose of Well: Domestic
(Domestic Irrigation, Municipal, Industrial, Other)

Description & Color of Materials Sand, Clay, Red Clay, Shell, etc.	Thick- ness Feet	Depth Feet
<u>Dark grey clay</u>	<u>0</u>	<u>6</u>
<u>Light grey clay</u>	<u>6</u>	<u>12</u>
<u>Blue clay</u>	<u>12</u>	<u>19</u>
<u>Dark lignite</u>	<u>19</u>	<u>25</u>
<u>Blue clay</u>	<u>25</u>	<u>47</u>
<u>Dark lignite</u>	<u>47</u>	<u>49</u>
<u>Dark light grey clay</u>	<u>49</u>	<u>70</u>
<u>Silt & mica</u>	<u>70</u>	<u>79</u>
<u>Dark lignite</u>	<u>79</u>	<u>95</u>
<u>Dark light grey clay</u>	<u>95</u>	<u>121</u>
<u>Med coarse sand</u>	<u>121</u>	<u>132</u>
<u>cut with clay</u>		
<u>Med fine sand</u>	<u>132</u>	<u>144</u>
<u>* sh.</u>		
<u>Coarse sand</u>	<u>144</u>	<u>155</u>

Information upon completion of well:

(1) Diameter 2 inches.

(2) Total Depth 155 feet.

(3) Water Level 103 feet below top of ground.

(4) Cased to 147, Size 2"


(5) Screen: Size 1/4", Length 6'

(6) Were any formations sealed against pollution?
_____ yes, _____ no.

If YES, depth of formation _____

Why _____

Drillers Remarks: _____

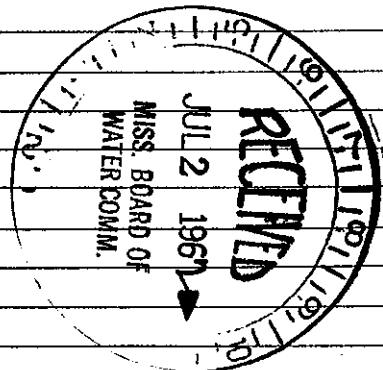

Well No.

(Use Back Side)

Mail this copy to Board of Water Commissioners 429 Miss. St. Jackson, Miss