

CODED

Probably in Kemper County

WINSTON
E. B. KEMPER
7-18-63

MISSISSIPPI BOARD OF WATER COMMISSIONERS

WATER WELL DRILLERS LOG

Date: 7-18, 1963, Driller: Merrett Drilling County Kemper
WINSTON
(Name)


(1) Owner of Land Mr Roy CRANE
(Name)
LINDVILLE, MISS
(Address)
(2) Location: 30 1/2 15
1/2 miles EAST of LINDVILLE
(distance) (direction) (Nearest Town)
(3) Topography: ✓
(Hilly) (Flat) (Level)
(4) Purpose of Well: Domestic
(Domestic Irrigation
Municipal, Industrial, Other)

Description & Color of Materials Sand, Clay, Red Clay, Shell, etc.	Thick- ness Feet	Depth Feet
RED CLAY	0	20
GRAY CLAY	20	21
CLAY SAND ROCK	21	35
Yellow clay mixed with SAND	35	50
SAND ROCK	50	52
LIGNITE	52	60
Blue CLAY	60	73
LIGNITE	73	95
Blue CLAY	75	85
GRAY CLAY	85	92
ROCK		92
GRAY CLAY	93	105
Trace of Blue SAND	105	126
Blue SAND	126	130
GRAY CLAY	130	185
FINE SAND	185	219
WHITE SAND	219	230

Information upon completion of well:

(1) Diameter 2 inches.
(2) Total Depth 231 feet.
(3) Water Level 122 feet below top of ground.
(4) Cased to 219, Size 2
(5) Screen: Size 1 1/4, Length 6'
(6) Were any formations sealed against pollution?
_____ yes, ✓ no.

If YES depth of formation _____
Why _____
Drillers Remarks: _____

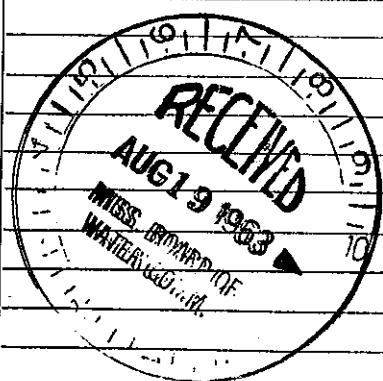

(Use Back Side)

Retain this copy for your office files.

Well No.