

KEMPER
 3 2000
 3-6-81
 3/6/

MISSISSIPPI
 BOARD OF WATER COMMISSIONERS
 416 North State Street
 Jackson, Mississippi 39201

WATER WELL DRILLERS LOG

Kemper
 Kemper

date/well completed

1981

firm name

county well located

Jerry Drilling Co

LANDOWNER:

C. S. Mathis
 Chalson, Miss
 (mailing address)

description of formations encountered

yellow + red clay
 sand
 clay
 sand

from to

0 75
 75 110
 110 150
 150 182

WELL LOCATION:


sec. 13-120 T-120 S R-15
 15 miles NW of Sebald.
 (distance) (direction) (nearest town)

WELL PURPOSE:

(home, irrigation, municipal, industrial)

WELL COMPLETION DATA:

- (1) diameter (inches) 2"
- (2) total depth (feet) 182
- (3) static water level (feet) 120 below top of ground.
- (4) casing pvc (material) (depth) (size) if telescope see back.
- (5) screen 10' 172' (length) (depth to top) (size) (material)
- (6) pump 1 1/2 5 (HP) (yield gpm) jet (type power)
- (7) electric log (yes or no) (organization running log)
- (8) how well bottom plugged wash valve

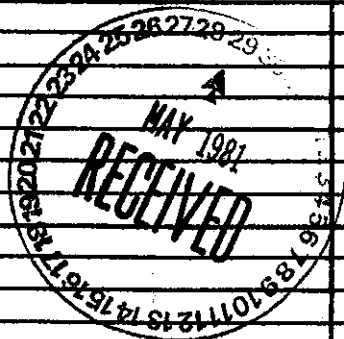

DRILLERS REMARKS: