

**CODED KEMPER WATER WELL DRILLERS LOG**

Date: May 11, 1965, Driller: Dunk Smith, County: Kemper  
 . 5-65 (Name)

(1) Owner of Land:	Description & Color of Materials Sand, Clay, Red Clay, Shell, etc.	Thick- ness Feet	Depth Feet
<u>Sam Missa</u> (Name)	<u>Top Soil</u>		<u>15</u>
<u>Scuba, Miss</u> (Address)	<u>Shale Stone</u>		<u>110</u>
(2) Location: <u>21 12 17</u> 1/4, 1/4, Sec. T. R.	<u>Lake Stone</u>		<u>860</u>
<u>5</u> miles <u>West</u> of <u>Wahala</u> (distance) (direction) (Nearest Town)	<u>First Sands</u>		<u>75</u>
(3) Topography: <u>✓</u> (Hilly) (Flat) (Level)	<u>Shale + gum</u>		<u>210</u>
(4) Purpose of Well: <u>House</u> (Domestic Irrigation Municipal, Industrial, Other)	<u>Second Sands</u>		<u>85</u>
			<u>1355</u>

**Information upon completion of well:**

(1) Diameter 4 inches.

(2) Total Depth 1355 feet.

(3) Water Level 40 feet below top of ground.

(4) Cased to 4" at top - 2" at bottom  
Perforated size 5/16" holes  
84'


(5) Screen: Size \_\_\_\_\_, Length \_\_\_\_\_.

(6) Were any formations sealed against pollution?  
✓ yes, \_\_\_\_\_ no.

If YES depth of formation 125'

Why Do Keep Out Surface Water

Drillers Remarks:

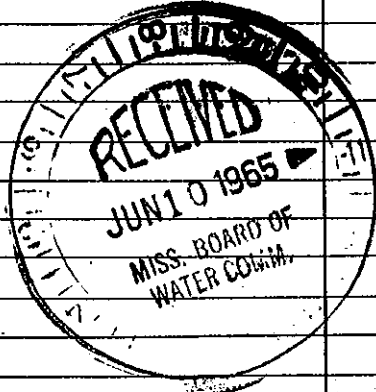

Well No.

(Use Back Side)

Mail this copy to Board of Water Commissioners 429 Miss. St. Jackson, Miss.