

MISSISSIPPI BOARD OF WATER COMMISSIONERS

KEMPER

CODED E26

WATER WELL DRILLERS LOG

E300

9-28-60


Date: Sept 28, 1960 Driller: Alvin Smith County: Kemper

(Name)

(1) Owner of Land	Description & Color of Materials Sand, Clay, Red Clay, Shell, etc.	Thick- ness Feet	Depth Feet
<u>Jean Bryan</u> (Name)	<u>Top soil</u>		<u>1</u>
<u>Seoaba Miss</u> (Address)	<u>Chalky grey</u>	<u>611</u>	<u>612</u>
(2) Location: <u>1/4, 1/4, Sec. T. R.</u>	<u>Sand grey</u>		
<u>10</u> miles <u>N.E.</u> , of <u>Seoaba</u> (distance) (direction) (Nearest Town)	<u>gray very fine</u>		<u>90702</u>
(3) Topography: <input checked="" type="checkbox"/> (Hilly) <input type="checkbox"/> (Flat) <input type="checkbox"/> (Level)	<u>Shale</u>	<u>95797</u>	<u>107904</u>
(4) Purpose of Well: <input type="checkbox"/> (Domestic Irrigation) <input type="checkbox"/> (Municipal, Industrial, Other)	<u>Coarse grey sand</u>		<u>1121016</u>

Information upon completion of well:

- (1) Diameter 4 inches.
- (2) Total Depth 1016 feet.
- (3) Water Level 82 feet below top of ground.
- (4) Cased to blue rock.
- (5) Screen: Size 100' perforated pipe.
- (6) Were any formations sealed against pollution?
top casing driven into blue rock to shut out surface water
yes, no, to shut out surface water
If YES depth of formation _____
- Why this fine stone
- Driller's remarks you drive enough top casing you will have trouble with surface water

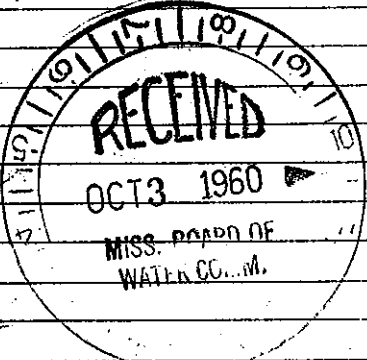

Well No. E300

(Use Back Side)

Retain this copy for your office files.