

KEMPER

CODED

WATER WELL DRILLERS LOG

E 21

7-24-62

Date July 24, 1962, Driller Ernest Smith County Kemper

(Name)


	Description & Color of Materials Sand, Clay, Red Clay, Shell, etc.	Thick- ness Feet	Depth Feet
(1) Owner of Land: Ernest Bryan (Name)	Top Soil	4	4
Scaoba Miss (Address)	like Stone	670	674
(2) Location: Brimley S 11 18? 1/4, 1/4, Sec. T. R.	First Sand	697	743
Community of (Stamville) 18E	Gum & Shale	212	955
_____ miles _____ of _____ (distance) (direction) (Nearest Town)	Second Sand	108	1113
(3) Topography: _____ (Hilly) (Flat) (Level)			
(4) Purpose of Well: _____ (Domestic Irrigation Municipal, Industrial, Other)			

Information upon completion of well:

- (1) Diameter 4 inches.
- (2) Total Depth 1063 feet.
- (3) Water Level 101 feet below top of ground.
- (4) Cased Pipe 8 1/2" Perforated Pipe Size _____
- (5) Screen: Size _____ Length _____
- (6) Were any formations sealed against pollution?
yes, no.

743
697
697
46

If YES depth of formation 21 feet
Why? Keep top soil
Driller's Remarks: Water out

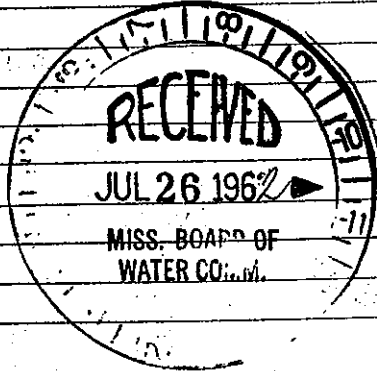

Well No.

(Use Back Side)

Mail this copy to Board of Water Commissioners 429 Miss. St. Jackson, Miss