

KEMPER
E 28

CODEL

Date: May, 1963, Driller: Kemper Drilling Co. County Kemper
5-03 1963 Kemper Drilling Co.

(1) Owner of Land: W. H. Parnell, Sr.
(Name)
(Address)
(2) Location: 23 12 18
1/4, 1/4, Sec. T₂₃R₁₈
5 miles NE of SCOORA
(distance) (direction) (Nearest Town)
(3) Topography: Hilly
(Hilly) (Flat) (Level)
(4) Purpose of Well: Domestic
(Domestic Irrigation
Municipal, Industrial, Other)

Description & Color of Materials Sand, Clay, Red Clay, Shell, etc.	Thick- ness Feet	Depth Feet
<u>Yellow sandy clay</u>	<u>18</u>	<u>18</u>
<u>Gray sand</u>	<u>20</u>	<u>38</u>
<u>White chalk</u>	<u>686</u>	<u>724</u>
<u>Green sandy shale +</u>		
<u>Green sand rock streak</u>	<u>158</u>	<u>882</u>
<u>Green sand + rock streak</u>	<u>31</u>	<u>913</u>
<u>Green sand + shale streak</u>	<u>32</u>	<u>945</u>

Information upon completion of well:

(1) Diameter 4 inches.

(2) Total Depth 945 feet.

(3) Water Level 125 feet below top of ground.

(4) Cased to 85', Size 4"


(5) Screen: Size NONE, Length _____

(6) Were any formations sealed against pollution?
____ yes, ____ no.

If YES depth of formation _____

Why _____

Drillers Remarks: _____

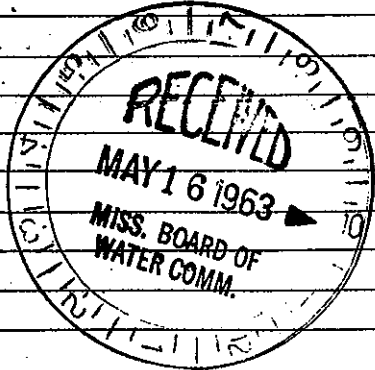

Well No.

(Use Back Side)

Mail this copy to Board of Water Commissioners 429 Miss. St. Jackson, Miss.