

**KEMPER WATER WELL DRILLERS LOG**

E 29

CODED

Date: 12-63 1963, Driller: Dennis Smith County Kemper  
 (Name)

(1) Owner of Land: <u>Joe Aust</u> <small>(Name)</small> <u>Seooha Miss</u> <small>(Address)</small> <u>5 1219</u>	Description & Color of Materials Sand, Clay, Red Clay, Shell, etc.	Thick- ness Feet	Depth Feet
(2) Location: <u>1/4</u> , <u>1/4</u> , Sec. <u>T R</u> <u>2</u> miles <u>South</u> of <u>Bismarck</u> <small>(distance) (direction) (Nearest Town)</small>	<u>Top soil &amp; soft</u> <u>lime stone</u> <u>lime stone</u> <u>1st sandy</u> <u>quartz &amp; shale</u> <u>2nd sand</u>		<u>17</u> <u>692</u> <u>65</u> <u>211</u> <u>109</u>
(3) Topography: <input checked="" type="checkbox"/> (Hilly) <input type="checkbox"/> (Flat) <input type="checkbox"/> (Level)			<u>1092</u>
(4) Purpose of Well: <u>House</u> <small>(Domestic Irrigation          Municipal, Industrial, Other)</small>			

Information upon completion of well:

(1) Diameter 4 inches.

(2) Total Depth 1092 feet.

(3) Water Level 110 feet below top of ground.

(4) Cased to 4" at top Size 2" at Bottom


(5) Screen: Size perforated 5/16 holes, Length 8 1/2'

(6) Were any formations sealed against pollution?  
 yes,  no.

If YES depth of formation 17'

Why to keep surface water out

Drillers Remarks:

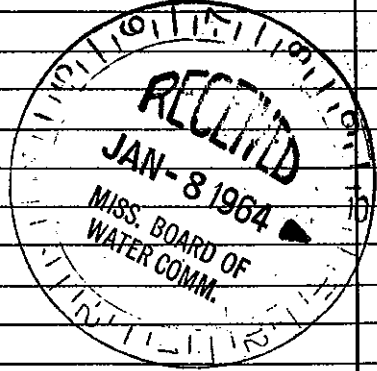

Well No.

(Use Back Side)

Mail this copy to Board of Water Commissioners 429 Miss. St. Jackson, Miss