

**KEMPER MISSISSIPPI BOARD OF WATER COMMISSIONERS**  
**E<sup>30</sup> CODED**


**WATER WELL DRILLERS LOG**

Date: Jan 5, 1966, Driller: Dunk Smith County: Kemper.  
 (Name)

(1) Owner of Land: <u>Cecil Cherry</u> (Name) <u>Scobee, Miss.</u> (Address)	Description & Color of Materials Sand, Clay, Red Clay, Shell, etc.	Thick- ness Feet	Depth Feet
(2) Location: $\frac{1}{4}$ , $\frac{1}{4}$ , Sec. <u>7 12 19</u> T. R. <u>9</u> miles <u>N.E.</u> of <u>Scobee</u> (distance) (direction) (Nearest Town)	<u>Top Soil.</u>		<u>28'</u>
(3) Topography: <input checked="" type="checkbox"/> (Hilly) <input type="checkbox"/> (Flat) <input type="checkbox"/> (Level)	<u>Limestone.</u>	<u>5</u>	<u>97</u>
(4) Purpose of Well: <u>House</u> (Domestic Irrigation Municipal, Industrial, Other)	<u>Gravel Sand.</u>		<u>95</u>
	<u>Shale &amp; gum.</u>	<u>1</u>	<u>95</u>
	<u>Second Sand.</u>		<u>90</u>
			<u>1005</u>

Information upon completion of well:

- (1) Diameter 4 inches.
- (2) Total Depth 1005 feet.
- (3) Water Level 82' feet below top of ground. 4" at top 2" at bottom
- (4) Cased to perforated Size 5/16" holes  
84 ft
- (5) Screen: Size \_\_\_\_\_, Length \_\_\_\_\_
- (6) Were any formations sealed against pollution?  
 yes, \_\_\_\_\_ no.
- If YES depth of formation 28 ft.
- Why To Keep Out Surface Water
- Drillers Remarks: \_\_\_\_\_

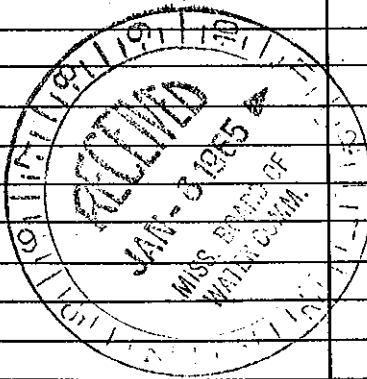

Well No.

(Use Back Side)

File this copy to Board of Water Commissioners 429 Miss. St. Jackson, Miss.