

KEMPER WATER WELL DRILLERS LOG

E 31 CODED

Date: 1/5, -65 1965, Driller: Dunk Smith County Kemper
 (Name)

(1) Owner of Land: <u>William M. Spencer</u> (Name) <u>Scoba, Miss</u> (Address)	Description & Color of Materials Sand, Clay, Red Clay, Shell, etc.	Thick- ness Feet	Depth Feet
(2) Location: <u>20 12/18</u> <u>4</u> miles <u>East</u> of <u>Scoba</u> (distance) (direction) (Nearest Town)	<u>top Soil & light lime stone</u> <u>lime stone</u> <u>1st sand</u> <u>lump + shale</u> <u>2nd sand</u>	<u>755</u> <u>65</u> <u>211</u> <u>107</u> <u>1155</u>	
(3) Topography: _____ (Hilly) (Flat) (Level)			
(4) Purpose of Well: <u>House</u> (Domestic Irrigation Municipal, Industrial, Other)			


Information upon completion of well:

- (1) Diameter 4 inches.
- (2) Total Depth 1155 feet.
- (3) Water Level 68 feet below top of ground. 4" at top - 2" at bottom - perforated 5/16 holes
- (4) Cased to _____, Size 84"
- (5) Screen: Size _____, Length _____
- (6) Were any formations sealed against pollution?
 yes, _____ no.

If YES depth of formation 17'

Why To keep surface water out

Drillers Remarks: _____

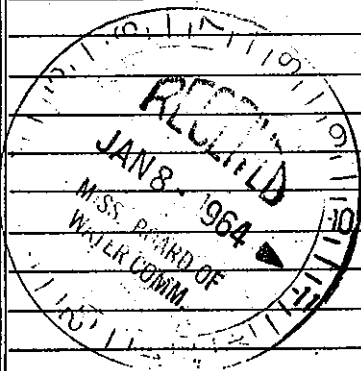

(Use Back Side)

Well No. _____

Mail this copy to Board of Water Commissioners 429 Miss. St. Jackson, Miss