

MISSISSIPPI BOARD OF WATER COMMISSIONERS

~~MEMBER~~ **KEMPER**

BF4

WATER WELL DRILLER **CODED**

KEMPER

Date: 6-1-61, 1961, Driller: R. B. Nicholas County: Madison
BC-80-2 Burton (Name) Bell

(1) Owner of Land: U.S. Grant
 (Name)
Shila - Miss -
 (Address)
 (2) Location: 35 1/4, 11, 14
17 miles East, of Shila.
 (distance) (direction) (Nearest Town)
 (3) Topography: Hilly
 (Hilly) (Flat) (Level)
 (4) Purpose of Well: Domestic
 (Domestic Irrigation
 Municipal, Industrial, Other)


Description & Color of Materials Sand, Clay, Red Clay, Shell, etc.	Thick- ness Feet	Depth Feet
<u>Chalk dirt</u>	<u>1</u>	<u>18</u>
<u>blue dirt</u>	<u>18</u>	<u>30</u>
<u>black dirt</u>	<u>30</u>	<u>78</u>
<u>water sand</u>	<u>78</u>	<u>95</u>

Information upon completion of well:

(1) Diameter: 3 7/8 inches.
 (2) Total Depth: 95 feet.
 (3) Water Level: 65 feet below top of ground.
 (4) Cased to: Bottom Size 2"
 (5) Screen: Size 1/4, Length 10'
 (6) Were any formations sealed against pollution?
 yes, no.

CODED

If YES depth of formation 2 ft. 4" pipe
 Why: Sanitary Purpose
 illers Remarks: fine sand

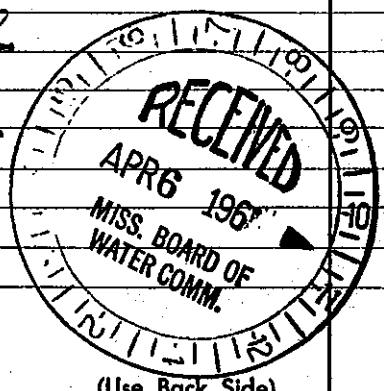

Well No.

(Use Back Side)