

CODED

MISSISSIPPI  
 BOARD OF WATER COMMISSIONERS  
 416 North State Street  
 Jackson, Mississippi 39201  
 WATER WELL DRILLERS LOG

KEMPER  
 H-6  
 6-67


JUNE 30 19 67 OGLETREE DRILLING KEMPER  
 date well completed firm name county well located

LANDOWNER: CALVIN ROBERTSON description of formations encountered from to  
 RT. 2 RED SAND 0 25  
 DEKALB, MISS. WHITE SAND 25 100  
 (mailing address)

WELL LOCATION:  
 sec 8 T. 11 N R. 16 E  
 S W  
 5 miles NORTH of DEKALB  
 (distance) (direction) (nearest town)

WELL PURPOSE: HOME USE  
 (home, irrigation, municipal, industrial)

WELL COMPLETION DATA:  
 (1) diameter (inches) 2"  
 (2) total depth (feet) 100  
 (3) static water level (feet) 85 below above top of ground.  
 (4) casing GAV. 95  
 (material) (depth)  
 (size) if telescope see back.  
 (5) screen 5ft 100-95  
 (length) (depth to top)  
 1 1/2 STAINLESS STEEL  
 (size) (material)  
 (6) pump 3/4 4  
 (HP) (yield gpm)  
 ELECTRIC  
 (type power)  
 (7) electric log NO  
 (yes or no)  
 (organization running log)  
 (8) how well bottom plugged FLUSH VALVE

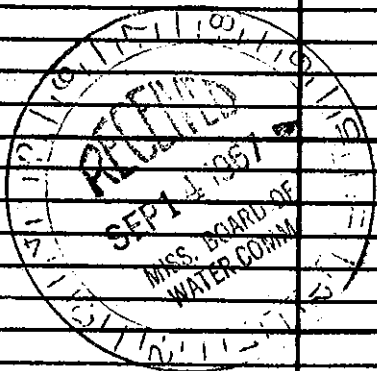

DRILLERS REMARKS: